


STATE OF KANSAS
STATE CORPORATION COMMISSION

15-025-28197-0000

WELL PLUGGING RECORD

Give All Information Completely
Make Required Affidavit
Mail or Deliver Report to
Conservation Division
State Corporation Comm.
245 North Water
Wichita, KS 67202

Clark County, Sec. 33 Twp. 31S Rge. 21W E/W
Location as "NE/CNW $\frac{1}{2}$ SW $\frac{1}{2}$ " or footage from lines
C NE SW
Lease Owner Mohawk Energy Corp.
Lease Name Vallentine Well No. 1A
Office Address 2401 Fourth Nat'l. Bank Bldg., Tulsa, Okla. 74119
Character of Well (Completed as Oil, Gas or Dry Hole)
Dry Hole

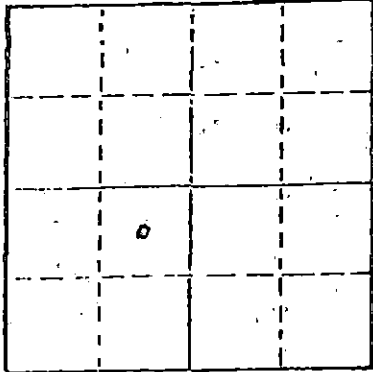

Locate well correctly on above
Section Plot

Date Well completed 2-5-78 19
Application for plugging filed 2-5-78 19
Application for plugging approved 2-5-78 19
Plugging commenced 2-5-78 19
Plugging completed 2-5-78 19

Reason for abandonment of well or producing formation
Dry and Abandoned
If a producing well is abandoned, date of last production
19

Was permission obtained from the Conservation Division or
its agents before plugging was commenced? Yes

Name of Conservation Agent who supervised plugging of this well Leo Massey
Producing formation None Depth to top Bottom Total Depth of Well
Show depth and thickness of all water, oil and gas formations:

OIL, GAS OR WATER RECORDS

CASING RECORD

FORMATION	CONTENT	FROM	TO	SIZE	PUT IN	PULLED OUT
	8-5/8"	0	652'	8-5/8		None

Describe in detail the manner in which the well was plugged, indicating where the mud fluid
was placed and the method or methods used in introducing it into the hold. If cement or other
plugs were used, state the character of same and depth placed, from feet to
feet for each plug set.

- Plug #1 - 675' with 50 sacks
- Plug #2 - 300' with 25 sacks
- Bridge & plug at 40' with 10 sacks
- Rathole - 5 sacks

RECEIVED
STATE CORPORATION COMMISSION
FEB 08 1978
CONSERVATION DIVISION
Wichita, Kansas

(If additional description is necessary, use BACK of this sheet)

Name of Plugging Contractor

STATE OF Okla. COUNTY OF Tulsa, ss.
Operator, Troy W. Mahoney (employee of owner) or (owner or operator)
of the above-described well, being first duly sworn on oath, says: That I have knowledge of
the facts, statements, and matters herein contained and the log of the above-described well
as filed and that the same are true and correct. So help me God.

(Signature) Troy W. Mahoney
Tulsa, Okla.
(Address)

SUBSCRIBED AND SWORN TO before me this 6th day of February, 19 78

Ruth M. McBryar
Notary Public.

My commission expires May 28, 1980

GABBERT-JONES, INC.
 WICHITA, KANSAS
 DRILLERS' WELL LOG

Valentine #1-A
 C-NE-SW Sec 33-31S-21W
 Clark County Kansas

Commenced: 1-20-78

Completed: 2-5-78

15-025-2097-0008

OPERATOR: MOHAWK ENERGY CORP.

Depth		Formation	Remarks
From	to		
0	250	Redbed-Clay	Ran 16 jts of 23# 8 5/8"
250	662	Redbed-Clay-Gyp	csg set @ 652' Cemented
662	706	Redbed-Shale	w/350 sks Howcolite
706	977	Shale-Redged	3% CC + 150 sks Common
977	2100	Shale	3% CC PD @ 2:30 a.m.
2100	2310	Lime-Shale	1-21-78
2310	2645	Shale-Lime	
2645	3445	Lime-Shale	
3445	3600	Shale-Lime	
3600	4390	Lime-Shale	
4390	5300	Lime	
	5300 - TD		DRY & ABANDONED

STATE OF KANSAS ()
) SS
 COUNTY OF SEDGWICK)

I, the undersigned, being duly sworn on oath, state that the above Drillers' Well Log is true and correct to the best of my knowledge and belief and according to the records of this office.

GABBERT-JONES, INC.

James S. Sutton II
 JAMES S. SUTTON II

Subscribed and sworn to before me this 15th day of February, 1978.

Elizabeth J. Edwards
 ELIZABETH J. EDWARDS-NOTARY PUBLIC

My Commission expires February 6, 1979.

RECEIVED
 STATE CORPORATION COMMISSION

FEB 21 1978

CONSERVATION DIVISION
 Wichita, Kansas

NOTARY PUBLIC
 1978