

STATE OF KANSAS
STATE CORPORATION COMMISSION


Form CP-4

Give All Information Completely
Make Required Affidavit
Mail or Deliver Report to:
Conservation Division
State Corporation Commission
212 No. Market
Wichita, Kansas

WELL PLUGGING RECORD

Barber County, Sec. 22 Twp. ^{31S} ~~20S~~ Rge. 13W/(E) (W)

Location as "NE/CNW/SW" or footage from lines C SW NW
Lease Owner X Leben Drilling, Inc.
Lease Name Smith Well No. 1
Office Address Box 486, Great Bend, Kansas 67530
Character of Well (completed as Oil, Gas or Dry Hole) Dry Hole
Date well completed 4-29-66 19
Application for plugging filed 4-29-66 19
Application for plugging approved 4-29-66 19
Plugging commenced 4-29-66 19
Plugging completed 4-29-66 19
Reason for abandonment of well or producing formation Dry Hole

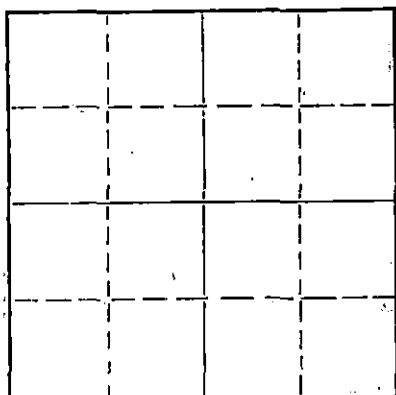

Locate well correctly on above Section Plat

If a producing well is abandoned, date of last production 19
Was permission obtained from the Conservation Division or its agents before plugging was commenced? yes

Name of Conservation Agent who supervised plugging of this well Archie Elving, Pratt, Kansas 67124
Producing formation _____ Depth to top _____ Bottom _____ Total Depth of Well 3830 Feet
Show depth and thickness of all water, oil and gas formations.


OIL, GAS OR WATER RECORDS

CASING RECORD

FORMATION	CONTENT	FROM	TO	SIZE	PUT IN:	PULLED OUT
				8 5/8"	303'	none

Describe in detail the manner in which the well was plugged, indicating where the mud fluid was placed and the method or methods used in introducing it into the hole. If cement or other plugs were used, state the character of same and depth placed, from _____ feet to _____ feet for each plug set.

Mudded to 280', set plug, 1/2 sk. hulls, 25 sks. cement
Mudded to 40', set plug, 1/2 sk. hulls, 10 sks. cement
put 2 sks. in rathole

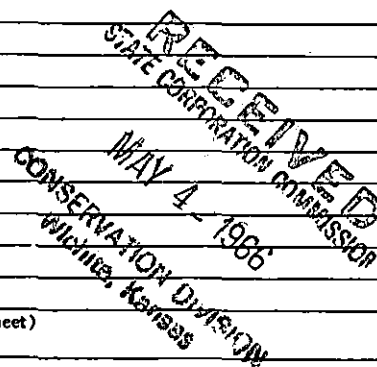

(If additional description is necessary, use BACK of this sheet)

Name of Plugging Contractor Leben Drilling, Inc.
Address Box 486, Great Bend, Kansas 67530

STATE OF KANSAS, COUNTY OF BARTON, ss.

Leslie Kite (employee of owner) or (owner or operator) of the above-described well, being first duly sworn on oath, says: That I have knowledge of the facts, statements, and matters herein contained and the log of the above-described well as filed and that the same are true and correct. So help me God.

(Signature) Leslie Kite
P. O. Box 486, Great Bend, Kansas 67530
(Address)

SUBSCRIBED AND SWORN TO before me this 2nd day of May, 1966

My commission expires 4-1-67

Wanda Dickler
Notary Public.

DRILLER'S LOG

COMPANY: Leben Drilling, Inc.
 CONTRACTOR: LEBEN DRILLING, INC.
 FARM: SMITH #1
 LOCATION: C SW NW Sec. 22-³¹21S-13W
 BARBER COUNTY, KANSAS
 COMMENCED: 4-23-66
 COMPLETED: 4-29-66

15-007-30232-0000

0	205	Sand
205	957	Redbed, Shale
957	1080	Redbed
1080	1550	Shale
1550	2045	Lime, Shale
2045	2215	Lime
2215	2525	Lime, Shale
2525	3370	Shale, Lime
3370	3390	Lime
3390	3668	Lime, Shale
3668	3815	Shale, Lime
3815	3830	Lime
	<u>3830</u>	<u>RTD - D. & A.</u>

RECEIVED
 STATE CORPORATION COMMISSION
 MAY 4 - 1966
 CONSERVATION DIVISION
 Wichita, Kansas

Set 8 5/8" used 32# surface casing @ 303' with 225 sacks Common, 2% cc

I, Leslie Kite, do hereby certify that the above and foregoing is a true and correct copy of the log of the Smith #1 well, located C SW NW of Section 22, Township 21 South, Range 13 West, Barber County, Kansas, as reflected by the records of Leben Drilling, Inc.

Leslie Kite
 Leslie Kite

STATE OF KANSAS)
) SS
 COUNTY OF BARTON)

Subscribed and sworn to and before me, a Notary Public, in and for Barton County, Kansas, this 2nd day of May, 1966.

Mlanda Pechala
 -Leslie Kite-

My Commission Expires:
April 1, 1967