

15-007-00-151-0000

STATE OF KANSAS
STATE CORPORATION COMMISSION


Give All Information Completely
Make Required Affidavit
Mail or Deliver Report to:
Conservation Division
State Corporation Commission
800 Bitting Building
Wichita, Kansas

WELL PLUGGING RECORD

Barber County, Sec. 23 Twp. 31S Rge. (X) 13 (W)

Location as "NE/CNWxSWx" or footage from lines NE-NE-NE
Lease Owner Champlin Oil & Refining Co.
Lease Name Hannah V. Nurse Well No. 1
Office Address P.O. Box 167, Ellinwood, Kansas
Character of Well (completed as Oil, Gas or Dry Hole) Gas
Date well completed March 20, 19 53
Application for plugging filed August 4, 19 58
Application for plugging approved August 4, 19 58
Plugging commenced August 5, 19 58
Plugging completed August 9, 19 58
Reason for abandonment of well or producing formation Non Productive

NORTH

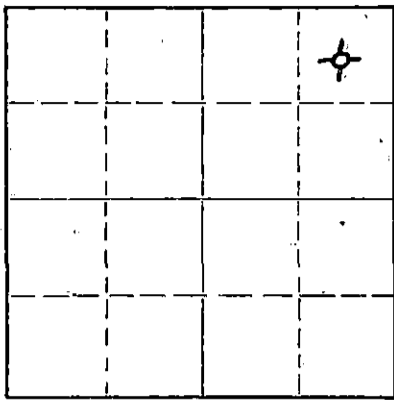

Locate well correctly on above
Section Plat

If a producing well is abandoned, date of last production March 19 57
Was permission obtained from the Conservation Division or its agents before plugging was commenced? Yes

Name of Conservation Agent who supervised plugging of this well W. L. Lackamp
Producing formation _____ Depth to top _____ Bottom _____ Total Depth of Well 4705 Feet
Show depth and thickness of all water, oil and gas formations. (3775 PBD)

OIL, GAS OR WATER RECORDS

CASING RECORD

FORMATION	CONTENT	FROM	TO	SIZE	PUT IN	PULLED OUT
				8-5/8OD	200'	None
				5-1/2OD	4310'	3140'

Describe in detail the manner in which the well was plugged, indicating where the mud fluid was placed and the method or methods used in introducing it into the hole. If cement or other plugs were used, state the character of same and depth placed, from _____ feet to _____ feet for each plug set.

Filled hole with sand from 3775' PBD to 3590' and ran 5 sacks of cement from 3590' to 3565'. Shot off casing at 3140' and picked up casing to 1700'. Mixed and pumped in 15 sacks of mud. Set rock bridge 210' to 200' and ran 20 sacks of cement from 200' to 140'. Mudded 140' to 40'. Rock from 40' to 30' and pumped in 10 sacks of cement filling hole to the base of cellar.

(If additional description is necessary, use BACK of this sheet)

Name of Plugging Contractor Glenn & Smith Pipe Pulling Co.
Address Ellinwood, Kansas.

STATE OF Kansas COUNTY OF Barton, ss.
J. W. Meyers (employee of owner) or (owner or operator) of the above-described well, being first duly sworn on oath, says: That I have knowledge of the facts, statements, and matters herein contained and the log of the above-described well as filed and that the same are true and correct. So help me God.

(Signature) *J. W. Meyers*
Box 167, Ellinwood, Kansas
(Address)

SUBSCRIBED AND SWORN TO before me this 12th day of August, 19 58

My commission expires 5-22-62

Notary Public.

PLUGGING
FILE SEC 23 T 31 S R 13 W
BOOK PAGE 119 LINE 35

RECEIVED
STATE CORPORATION COMMISSION
AUG 13 1958
CONSERVATION DIVISION
Wichita, Kansas

CHAMPLIN OIL & REFINING CO.

NURSE #1 WELL
 330 Feet from the East
 Line and 330 Feet from the
 North Line of the North-
 east Quarter (NE $\frac{1}{4}$) of Sec-
 tion 23-3E-23W-Barber Co.,
 Kansas

FORMATION LOG

0'	-	780'	Red Shale
780'	-	925'	Red & Blue Shale
925'	-	1415'	Shale & Red Bed Shale
1415'	-	1450'	Anhydrite
1450'	-	1855'	Shale
1855'	-	1985'	Shale & Lime
1985'	-	2586'	Shale & Lime
2586'	-	2870'	Shale
2870'	-	3185'	Shale & Lime
3185'	-	3230'	Shale
3230'	-	3330'	Shale & Lime
3330'	-	3480'	Shale & Sand
3480'	-	3575'	Shale & Lime
3575'	-	3775'	Shale & Sand
3775'	-	3822'	K. C. Lime
3822'	-	4308'	Shale & Lime
4308'	-	4350'	Chert & Lime
4350'	-	4505'	Lime, & Shale
4505'	-	4556'	Lime, Shale & Chert
4556'	-	4595'	Sand & Shale
4595'	-	4650'	Sand & Shale
4650'	-	4665'	Arbuckle Lime
4665'	-	4705'	Lime
4705'	-		Total Depth
3775'	-		Plug Back Total Depth

RECEIVED
 STATE CORPORATION COMMISSION

AUG 4 1950

CONSERVATION DIVISION

PLUGGING

FILE SEC 23 T 31 R 13W
 BOOK PAGE 49 LINE 35