

15-007-01051-0001

STATE OF KANSAS  
STATE CORPORATION COMMISSION

WELL PLUGGING RECORD

Give All Information Completely  
Make Required Affidavit  
Mail or Deliver Report to:  
Conservation Division  
State Corporation Commission  
800 Bitting Building  
Wichita, Kansas

Barber County, Sec. 23 Twp. 31s Rge. (E) 13 (W)

Location as "NE/CNW/SW" or footage from lines. NE 1/4 - NE 1/4 - SE 1/4

Lease Owner Champlin Refining Company

Lease Name Riley C. Parr Well No. 1

Office Address Dr. #552, Enid, Oklahoma

Character of Well (completed as Oil, Gas or Dry Hole) Dry Hole

Date well completed March 20, 1953

Application for plugging filed March 29, 1954

Application for plugging approved April 10, 1954


Plugging commenced April 12, 1954

Plugging completed April 12, 1954

Reason for abandonment of well or producing formation

If a producing well is abandoned, date of last production 19

Was permission obtained from the Conservation Division or its agents before plugging was commenced? Yes

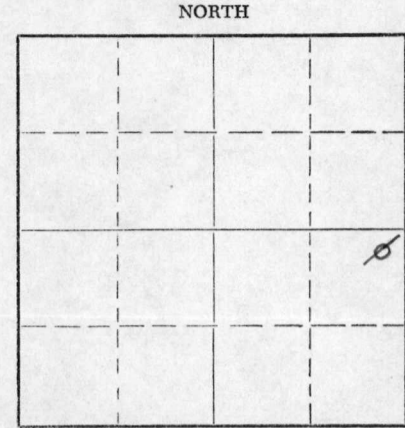

Locate well correctly on above Section Plat

Name of Conservation Agent who supervised plugging of this well Mr. M. A. Rives

Producing formation Depth to top Bottom Total Depth of Well Feet

Show depth and thickness of all water, oil and gas formations.

OIL, GAS OR WATER RECORDS

CASING RECORD

FORMATION	CONTENT	FROM	TO	SIZE	PUT IN	PULLED OUT
				10 3/4" OD	211'	None

Describe in detail the manner in which the well was plugged, indicating where the mud fluid was placed and the method or methods used in introducing it into the hole. If cement or other plugs were used, state the character of same and depth placed, from feet to feet for each plug set.

Hole was filled with heavy rotary mud from 3977' T.D. to 200', we set wooden plug at 200' and filled hole with cement using 100 sacks, from wooden plug at 200' to 6' or bottom of cellar. Used Halliburton to plug well

(If additional description is necessary, use BACK of this sheet)

Name of Plugging Contractor Champlin Refining Company  
Address P.O. Dr. #552, Enid, Oklahoma

STATE OF Kansas, COUNTY OF Barton, ss. S. P. Hall (employee of owner) or (owner or operator) of the above-described

well, being first duly sworn on oath, says: That I have knowledge of the facts, statements, and matters herein contained and the log of the above-described well as filed and that the same are true and correct. So help me God.

(Signature) S. P. Hall

P.O. Box 167, Ellinwood, Kansas (Address)

SUBSCRIBED AND SWORN TO before me this 15th day of April, 19 54

My commission expires Sept. 10, 1955

Notary Public. N. Kenneth Sturtevant

PLUGGING  
FILE SEC 23 T 31 S 13 W  
BOOK PAGE 23 LINE 32

24-2675-5 2-52-20M

RECEIVED  
STATE CORPORATION COMMISSION  
4-16-54 APR 16 1954  
CONSERVATION DIVISION  
Wichita, Kansas