


15-007-00436-0000

STATE OF KANSAS  
STATE CORPORATION COMMISSION  
Give All Information Completely  
Make Required Affidavit  
Mail or Deliver Report to:  
Conservation Division  
State Corporation Commission  
800 Biting Building  
Wichita, Kansas

WELL PLUGGING RECORD

Barber County. Sec 25 Twp. 31s Rge. (E) 13 (W)  
Location as "NE/CNW/SW" or footage from lines NW-SE-NW  
Lease Owner Champlin Refining Company  
Lease Name Roessler B Well No. 1  
Office Address P.O. Drawer #552, Enid, Oklahoma  
Character of Well (completed as Oil, Gas or Dry Hole) Dry hole  
Date well completed March 25, 1953  
Application for plugging filed March 25, 1953  
Application for plugging approved March 25, (Verbal) 1953  
Plugging commenced March 25, 1953  
Plugging completed March 25, 1953  
Reason for abandonment of well or producing formation \_\_\_\_\_

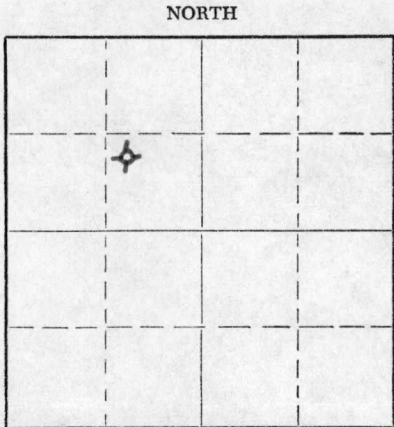

Locate well correctly on above Section Plat

If a producing well is abandoned, date of last production \_\_\_\_\_ 19\_\_\_\_  
Was permission obtained from the Conservation Division or its agents before plugging was commenced? Yes

Name of Conservation Agent who supervised plugging of this well M. A. Rives  
Producing formation \_\_\_\_\_ Depth to top \_\_\_\_\_ Bottom \_\_\_\_\_ Total Depth of Well 3930 Feet  
Show depth and thickness of all water, oil and gas formations.

OIL, GAS OR WATER RECORDS

CASING RECORD

FORMATION	CONTENT	FROM	TO	SIZE	PUT IN	PULLED OUT
				10 3/4"OD	217'	None

Describe in detail the manner in which the well was plugged, indicating where the mud fluid was placed and the method or methods used in introducing it into the hole. If cement or other plugs were used, state the character of same and depth placed, from \_\_\_\_\_ feet to \_\_\_\_\_ feet for each plug set.

Filled hole with heavy rotary mud from 3930' T.D. to 210' and set wooden plug at 210' and pumped in 25 sacks of cement then filled hole with heavy mud from top of cement to 35' and set wooden plug and pumped in 15 sacks of cement filling hole to surface.

RECEIVED  
STATE CORPORATION COMMISSION  
4-2-53  
APR 2 - 1953  
CONSERVATION DIVISION  
Wichita, Kansas

(If additional description is necessary, use BACK of this sheet)  
Name of Plugging Contractor Garvey Drilling Company  
Address Wichita, Kansas

STATE OF Kansas, COUNTY OF Barton, ss.  
\_\_\_\_\_(employee of owner) or (owner or operator) of the above-described well, being first duly sworn on oath, says: That I have knowledge of the facts, statements, and matters herein contained and the log of the above-described well as filed and that the same are true and correct. So help me God.

(Signature) S. P. Hall  
P.O. Box 167, Ellinwood, Kansas  
(Address)

SUBSCRIBED AND SWORN TO before me this 31st day of March, 1953

My commission expires September 10, 1955  
W. Kenneth Steiner  
Notary Public.

24-2675-S 2-52-20M

PLUGGING  
FILE SEC 25 T 31 R 134  
BOOK PAGE 87 LINE 33-

15-007, 00436-0600

DRILLER'S LOG ROESSLER 'B' NO. 1

Champlin Refining Company, Operator

Section 25, Twp. 31S., Rge. 13W

Garvey Drilling Company, Contractor

Location: NW SE NW

Drilling Commenced: March 10, 1953

County: Barber County, Kansas

Drilling Completed: March 25, 1953

R.T.D.: 3930'

Casing Record: 10 3/4" @ 217' w/150 sax

Production: D & A

Figures below indicate bottom of formation:

35	Red Bed
50	Sand
223	Red Rock
1100	Shale & Shells
1300	Shale & Salt
1625	Shale & Shells
1950	Lime & Shale
2395	Lime
2020	Lime & Shale
2215	Lime
2955	Lime & Shale
3165	Lime
3255	Lime & Shale
3554	Lime
3567	Sand
3665	Sandy Lime
3930	Lime

Tops:

Heebner:	3174	(-1918)
Douglas:	3554	(-1998)
Lansing:	3668	(-2112)

Plugging Record: Mudded up to 210' and set first wooden plug at 210' w/25 sacks cement. Mudded up to 35' and set second wooden plug at 35' and cemented with 15 sacks cement to surface.

3930' R.T.D.

I hereby certify that this is a true and correct log of the above mentioned well.

GARVEY DRILLING COMPANY

By W.W. Fisher

STATE OF KANSAS )  
                          ) SS:  
COUNTY OF SEDGWICK )

STATE OF KANSAS )  
APR 24 1953  
CONSERVATION DIVISION  
Wichita, Kansas

Subscribed to and sworn to before me, a Notary Public, in said County and State, this 30th day of March, 1953.

Charlotte Heiser  
Notary Public

My commission expires: October 13, 1954.

15-007-00436-0000

Champlin Refining Company  
Roessler B #1  
NW $\frac{1}{4}$ -SE $\frac{1}{4}$ -NW $\frac{1}{4}$   
Section 25 T31s R13w  
Barber County, Kansas

35 Red Bed  
50 Sand  
223 Red Rock  
1110 Shale & Shells  
1300 Shale & Salt  
1625 Shale & Shells  
1950 Lime & Shale  
2395 Lime  
2020 Lime & Shale  
2215 Lime  
2955 Lime & Shale  
3165 Lime  
3255 Lime & Shale  
3554 Lime  
3567 Sand  
3665 Sandy Lime  
3930 Lime  
3930 R.T.D.

CONSERVATION DIVISION  
Wichita, Kansas

**PLUGGING**  
FILE SEC 25 T 31 R 13 W  
BOOK PAGE 87 LINE 33