


WELL PLUGGING RECORD 15-007-30143-0000

Give All Information Completely
Make Required Affidavit
Mail or Deliver Report to:
Conservation Division
State Corporation Commission
211 No. Broadway
Wichita, Kansas

Barber County, Sec. 5 Twp. 31S Rge. (E) 12 (W)

Location as "NE/CNW/SW" or footage from lines. CS₁/₂ SW SW
Lease Ownr. Lario Oil & Gas Company
Lease Name Gress-Winter "B" Well No. 1
Office Address 301 S. Market, Wichita, Kansas 67202
Character of Well (completed as Oil, Gas or Dry Hole) Gas
Date well completed October 23 1965
Application for plugging filed December 12 1972
Application for plugging approved December 13 1972
Plugging commenced February 15 1973
Plugging completed February 17 1973
Reason for abandonment of well or producing formation Depleted

NORTH

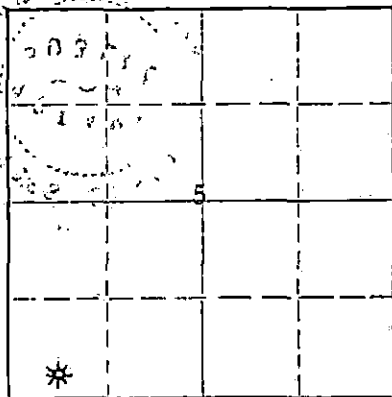

Locate well correctly on above Section Flat

If a producing well is abandoned, date of last production September 1 1972
Was permission obtained from the Conservation Division or its agents before plugging was commenced? Yes

Name of Conservation Agent who supervised plugging of this well Russell Biberstien
Producing formation Douglas Depth to top 3680 Bottom 3701 Total Depth of Well 3750 Feet
Show depth and thickness of all water, oil and gas formations.

OIL, GAS OR WATER RECORDS

CASING RECORD

FORMATION	CONTENT	FROM	TO	SIZE	PUT IN	PULLED OUT
				8 5/8"	217	None
				2 1/2"	3733 Set @ 3749	2427'

Describe in detail the manner in which the well was plugged, indicating where the mud fluid was placed and the method or methods used in introducing it into the hole. If cement or other plugs were used, state the character of same and depth placed, from _____ feet to _____ feet for each plug set.

Howco pumped 15 sacks cement plug to 3350'.
Clarke Oil Field Service set 10' rock plug at 200'.
Redi-mix cement to base of cellar.

RECEIVED
STATE CORPORATION COMMISSION

FEB 28 1973

CONSERVATION DIVISION
Wichita, Kansas

(If additional description is necessary, use BACK of this sheet)

Name of Plugging Contractor Clarke Oil Field Service
Address Medicine Lodge, Kansas


STATE OF Kansas, COUNTY OF Sedgwick, ss.
G. R. Kelsey (employee of owner) or (owner or operator) of the above-described well, being first duly sworn on oath, says: That I have knowledge of the facts, statements, and matters herein contained and the log of the above-described well as filed and that the same are true and correct. So help me God.

(Signature) G. R. Kelsey, Div. Prod. Supt.
301 S. Market, Wichita, Kansas 67202
(Address)

SUBSCRIBED AND SWORN TO before me this 21st day of February, 1973

July 21, 1974

Notary Public.

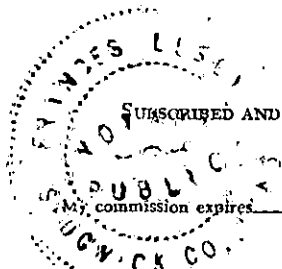

LARIO OIL & GAS COMPANY
 Gress-Winter "B" No. 1
 Gen. S/2 SW SW Sec. 5-31S-12W
 Barber County, Kansas

RECEIVED
 STATE CORPORATION COMMISSION
 DEC 13 1972
 CONSERVATION DIVISION
 Wichita, Kansas

Drilling Commenced: 8-24-65
 Drilling Completed: 9-1-65
 Well Completed: 10-23-65
 Drilling Contractor: White & Ellis Drilling, Inc.
 Total Depth 3750'
 I.P. - 4-point test 700 M.C.F.

15-007 - 30143-0000

Casing Record:
 8 5/8" 217' (T.O.) Set @ 224'
 Cem. w/ 110 sacks
 2 1/2" 3733.13 (T.O.) Set @ 3749'
 Cem. w/ 100 sacks

<u>Formation</u>	<u>Depth</u>
Cellar	12
Clay and red rock	227
Red rock & shale	715
Shale	1655
Lime	2155
Sand	2265
Lime	2440
Lime, shale, sandy	2750
Lime & shale	3000
Lime	3197
Shale & lime	3580
Lime	3680
Sand	3705
Lime & shale	3725
Lime	3750

<u>Electric Log Tops - K.B. Meas.</u>	
<u>Elevation</u>	
1741'	K.B.
1739'	D.F.
1732'	G.L.
3623'	(-1882)
3638'	(-1897)
3660'	(-1919)
3680'	(-1939)
3701'	(-1960)
3708'	(-1967)
3750'	(-2009)