


WELL PLUGGING RECORD 15-007-30226-0000

Give All Information Completely
Make Required Affidavit
Mail or Deliver Report to:
Conservation Division
State Corporation Commission
212 No. Market
Wichita, Kansas

Barber County. Sec. 5 Twp. 31 Rge. 12 (E) W (W)
Location as "NE/CNW/SW" or footage from lines SW
Lease Owner Midwestern Supply Co., Inc.
Lease Name Gress Well No. #1
Office Address 710 Union Natl. Bldg.; Wichita, KS. 67202
Character of Well (completed as Oil, Gas or Dry Hole) _____
Date well completed _____ 19____
Application for plugging filed August 1970
Application for plugging approved August 1970
Plugging commenced August 11 1970
Plugging completed August 14 1970
Reason for abandonment of well or producing formation _____

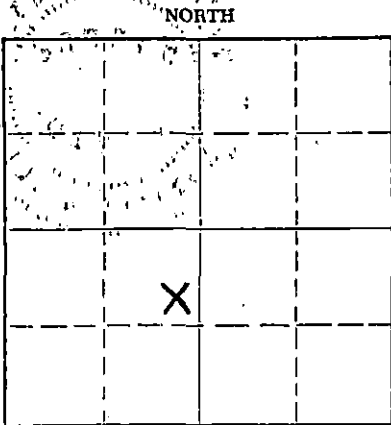

Locate well correctly on above Section Plat

If a producing well is abandoned, date of last production _____ 19____
Was permission obtained from the Conservation Division or its agents before plugging was commenced? Yes

Name of Conservation Agent who supervised plugging of this well Russell Biberstein
Producing formation _____ Depth to top _____ Bottom _____ Total Depth of Well _____ Feet
Show depth and thickness of all water, oil and gas formations.

OIL, GAS OR WATER RECORDS

CASING RECORD

FORMATION	CONTENT	FROM	TO	SIZE	PUT IN	PULLED OUT
				8 5/8	209	None
				4 1/2	3828	3195

Describe in detail the manner in which the well was plugged, indicating where the mud fluid was placed and the method or methods used in introducing it into the hole. If cement or other plugs were used, state the character of same and depth placed, from _____ feet to _____ feet for each plug set.

August 11, 1970 Plugged off bottom. Dumped sand to 3700'. Mixed and dumped 4 sx of cement to 3650'.
August 14, 1970 Plugged off top. Set 10' rock bridge from 195' to 205'. Filled 8 5/8" surface casing with 3000 lb. P.S.I. ready mix concrete, from 195' to base of cellar.

RECEIVED
STATE CORPORATION COMMISSION
SEP 15 1970
CONSERVATION DIVISION
Wichita, Kansas

(If additional description is necessary, use BACK of this sheet)

Name of Plugging Contractor Russ Casing Pulling, Inc.
Address P. O. Box 1082 Great Bend, Kansas 67530

STATE OF Kansas, COUNTY OF Sedgewick, ss.
Robert M. Brentlinger (employee of owner) or (owner or operator) of the above-described well, being first duly sworn on oath, says: That I have knowledge of the facts, statements, and matters herein contained and the log of the above-described well as filed and that the same are true and correct. So help me God.

(Signature) [Signature]
710 Union National Bldg
(Address)

Sworn to before me this 14th day of September, 1970



Betty Patterson
Notary Public.

May 22, 1971

COPY

WELL LOG BUREAU—KANSAS GEOLOGICAL SOCIETY
508 East Murdock, Wichita, Kansas


15-007-30226-0000

Company. CHIEF DRILG, INC.
Farm. Gress No. 1

SEC. 5 T. 31 R. 12W
C S LINE

Total Depth. 3820
Comm. 12-6-65 Comp. 12-13-65
Shot or Treated.
Contractor. Vaughan Drilg.
Issued. 3-12-66

County Barber
KANSAS

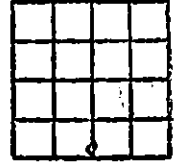

Elevation. 1792'KD

Production. 1600 MCFGPD

Figures Indicate Bottom of Formations.

clay, sand & red bed	40
red bed	675
Anhydrite	677
red bed, shale & shells	1100
shale & shells	1505
lime stringers & shale	1670
shale & shells	1740
shale & lime	3706
shale	3731
sand	3758
shale	3820
Total Depth	

RECEIVED
STATE CORPORATION COMMISSION
SEP 15 1970
CONSERVATION DIVISION
Wichita, Kansas

LOG TOPS:

Heebner	3675
Toronto	3688
Douglas Shale	3706
Upper Douglas Sandstone	3731
Base of Upper Douglas Sandstone	3758