


WELL PLUGGING RECORD

STATE OF KANSAS STATE CORPORATION COMMISSION Give All Information Completely Make Required Affidavit Mail or Deliver Report to: Conservation Division State Corporation Commission 211 No. Broadway Wichita, Kansas

Barber County. Sec. 23 Twp. 31S Rge. (E) 12 (W) Location as "NE/CNW/SW" or footage from lines C NE/4 SW/4 Lease Owner Walters Drilling Co., et al Lease Name Updegraff Well No. 1 Office Address 510 Orpheum Building, Wichita 2, Kansas Character of Well (completed as Oil, Gas or Dry Hole) Dry Hole Date well completed February 12 19 58 Application for plugging filed (verbal) February 12 19 58 Application for plugging approved (verbal) February 12 19 58 Plugging commenced February 12 19 58 Plugging completed February 12 19 58 Reason for abandonment of well or producing formation Dry Hole

NORTH

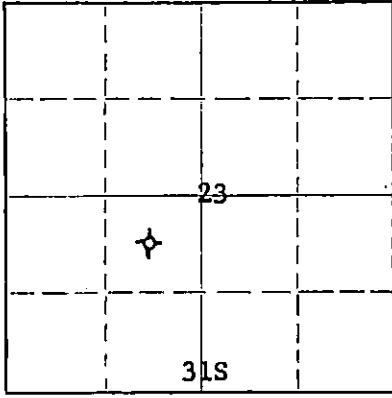

Locate well correctly on above Section Plat

If a producing well is abandoned, date of last production 19 Was permission obtained from the Conservation Division or its agents before plugging was commenced? Yes

Name of Conservation Agent who supervised plugging of this well W. L. Lackamp, Stafford, Kansas Producing formation None Depth to top Bottom Total Depth of Well 4350 Feet Show depth and thickness of all water, oil and gas formations.

OIL, GAS OR WATER RECORDS

CASING RECORD

Table with 7 columns: FORMATION, CONTENT, FROM, TO, SIZE, PUT IN, PULLED OUT. Row 1: None, None, 0, 215', 8 5/8", 215', None. Row 2: No production string - D & A

Describe in detail the manner in which the well was plugged, indicating where the mud fluid was placed and the method or methods used in introducing it into the hole. If cement or other plugs were used, state the character of same and depth placed, from feet to feet for each plug set.

Filled hole with heavy mud to 200', set bottom plug at 200' with 20 sacks cement.

Filled hole with heavy mud to 35', set top plug at 35' with 10 sacks cement.

RECEIVED ST. CORP. DIVISION FEB 18 1958 CONSERVATION DIVISION Wichita, Kansas

(If additional description is necessary, use BACK of this sheet)

Name of Plugging Contractor Walters Drilling Co. Address 510 Orpheum Building, Wichita 2, Kansas

STATE OF Kansas COUNTY OF Sedgwick ss. Robert F. Walters (owner or operator) of the above-described well, being first duly sworn on oath, says: That I have knowledge of the facts, statements, and matters herein contained and the log of the above-described well as filed and that the same are true and correct. So help me God.

(Signature) Robert F. Walters 510 Orpheum Building, Wichita 2, Kansas (Address)

SUBSCRIBED AND SWORN TO before me this 13th day of February, 19 58.

Pauline Handwerker Notary Public.

My commission expires March 10, 1960

PLUGGING 23T 31R 12W BOOK PAGE 82 LINE 25

UPDEGRAFF NO. 1

Location: C NE/4 SW/4 Sec. 23-31S-12W,
Barber County, Kansas

Date Spudded: 1-29-58

Operator: Walters Drilling Co.

Rotary Completion: 2-12-58

Contractor: Walters Drilling Co.

Elevation: 1614 Gr
1617 DF
1619 KB

Surface Casing: 8 5/8" set at 215' with 175 sacks
cement and 3 Cal. Chloride

15-007-20286-00-00

Production
Casing: None. D & A

L O G

(Figures indicate bottom of formation)

Surface	0 to 215
Shale	1155
Shale and Shells	1776
Shale and Lime	1890
Lime	2040
Lime and Shale	2700
Shale	2845
Shale and Lime	3727
Sand	3740
Shale and Lime	3865
Lime	3925
Lime and Shale	4049
Lime	4320
Chert	4330
Total Depth	4350

The undersigned, Robert F. Walters, hereby certifies that the above log is a true and correct log of the formations encountered in drilling the above noted well as reflected by the Daily Drilling Reports.

WALTERS DRILLING CO.

By

Robert F. Walters

Subscribed and sworn to before me this
13th day of February, 1958

Pauline Neudruckman
Notary Public

My commission expires:
March 10, 1960

RECEIVED
STATE CORPORATION COMMISSION

FEB 14 1958

CONSERVATION DIVISION
Wichita

PLUGGING
FILED SEC 23 T. 31 R. 124
BOOK PAGE 82 LINE 25