


WELL PLUGGING RECORD

Give All Information Completely
Make Required Affidavit
Mail or Deliver Report to:
Conservation Division
State Corporation Commission
800 Biting Building
Wichita, Kansas

Barber County. Sec. 25 Twp. 31S Rge. 12 (X) (W)
Location as "NE/CNW/SW" or footage from lines NW NW NW
Lease Owner Beardmore Drilling Company
Lease Name Phye Well No. 1
Office Address 603 Petroleum Building, Wichita 2, Kansas
Character of Well (completed as Oil, Gas or Dry Hole) dry hole
Date well completed 8-29 19 53
Application for plugging filed 8-29 19 53
Application for plugging approved 8-29 19 53
Plugging commenced 8-29 19 53
Plugging completed 8-29 19 53
Reason for abandonment of well or producing formation dry hole

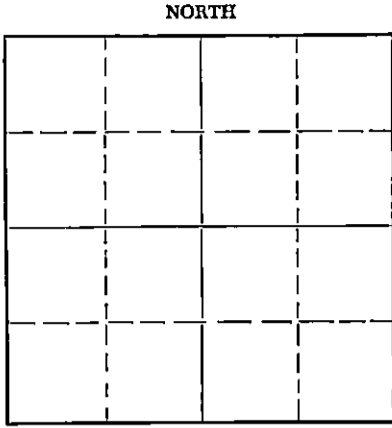

Locate well correctly on above Section Plat

If a producing well is abandoned, date of last production _____ 19____
Was permission obtained from the Conservation Division or its agents before plugging was commenced? Yes

Name of Conservation Agent who supervised plugging of this well M. A. Rives
Producing formation _____ Depth to top _____ Bottom _____ Total Depth of Well 4385 Feet
Show depth and thickness of all water, oil and gas formations.

OIL, GAS OR WATER RECORDS

CASING RECORD

FORMATION	CONTENT	FROM	TO	SIZE	PUT IN	PULLED OUT
<u>Redbck & Shale</u>		<u>0</u>	<u>160</u>	<u>8-5/8"</u>	<u>160</u>	<u>-0-</u>

Describe in detail the manner in which the well was plugged, indicating where the mud fluid was placed and the method or methods used in introducing it into the hole. If cement or other plugs were used, state the character of same and depth placed, from top feet to bottom feet for each plug set.

Heavy Mud from 155' to 4385'
Wood Plug @ 155'
20 Sacks Cement 95' to 155'
Heavy Mud from 40' to 95'
Wood Plug @ 40'
10 Sacks cement to surface

(If additional description is necessary, use BACK of this sheet)

Name of Plugging Contractor Beardmore Drilling Company
Address 603 Petroleum Building, Wichita 2, Kansas

STATE OF KANSAS COUNTY OF SEDGWICK, ss.
I, Heber Beardmore (employee of owner) or (owner or operator) of the above-described well, being first duly sworn on oath, says: That I have knowledge of the facts, statements, and matters herein contained and the log of the above-described well as filed and that the same are true and correct. So help me God.

(Signature) Heber Beardmore
603 Petroleum Bldg., Wichita 2, Kansas
(Address)

SUBSCRIBED AND SWORN to before me this 3rd day of September, 19 53

My commission expires January 28, 1956

24-7366-S 3-53-20M

RECEIVED - Notary Public.
STATE OF KANSAS CORPORATION COMMISSION

PLUGGING
FILE SEC 25 T 31 R 124
BOOK PAGE 125 LINE 33

SEP - 5 1953
CONSERVATION DIVISION
Wichita, Kansas

15-007-00440-00500

PHYE NO. 1

NW NW NW
Section 25-31S-12W
Barber County, Kansas

Drilled for: Beardmore, et al
Drilled by: Beardmore Drilling Company

Casing Record:

8-5/8" 160' w/100 Sacks

Drilling Commenced: August 16, 1953
Drilling Completed: August 29, 1953

Elevation:
KB 1597
GR 1591
DF 1594

<u>FORMATION</u>	<u>DEPTH</u>
Cellar	4
Red Rock - Shale	160
Red Bed	490
Shale - Shells	1650
Shale - Lime	1700
Lime - Shale	1870
Lime Broken	2030
Lime	2170
Lime - Shale	2250
Shale - Lime	2600
Lime - Shale	2765
Shale - Lime	3130
Lime - Shale	3700
Lime	4385 T. D.

D & A

TOPS:

Douglas Sand	3605
Lansing	3759
Mississippi	4293

DST #1 - 3606 - 14 - Open 1/2 hour. Good blow, recovered 990' water. BHP 1360#
Initial Flow Pressure 60#, FFP 480#

DST #2 - 4297-4325 - Open 1 hour, gas to surface 18 minutes. Estimated
300,000 Cu. Ft. Recovered 160' mud. Shut in 15 minutes.
BHP 1540#.

DST #3 - 4331-4369 - Open 1 hour, fair blow, shut in 15 minutes. Recovered
30' mud, 240' muddy salt water, 60' salt water, BHP 900#.

STATE OF KANSAS

ss

COUNTY OF SEDGWICK

I, the undersigned, being duly sworn on oath state that the above and within statement is a true and correct record and log of the well drilled on the location above-described, to the best of my knowledge and belief.

Heb Beardmore

Subscribed and sworn to before me this 3rd day of September 1953.

Leonard R. Tall
Notary Public

My Commission Expires: January 28, 1956.

RECEIVED
STATE CORPORATION COMMISSION

SEP 5 1953

CONSERVATION DIVISION
Wichita, Kansas

PLUGGING
FILE SEC 25 T31 R 124
BOOK PAGE 125 LINE 33