

WELL PLUGGING RECORD


Give All Information Completely
Make Required Affidavit
Mail or Deliver Report to:
Conservation Division
State Corporation Commission
211 No. Broadway
Wichita, Kansas

Barber

County. Sec. 25 Twp 31S Rge. 12W (E) (W)

T 31S NORTH R 12W

Location as "NE/CNW%SW%" or footage from lines. SW NE SW
Lease Owner Beardmore Drilling Company
Lease Name Phye Well No. 2
Office Address 827 Beacon Building - Wichita, Kansas
Character of Well (completed as Oil, Gas or Dry Hole) Oil well
Date well completed June 21 1955
Application for plugging filed December 27 1956
Application for plugging approved 19
Plugging commenced January 3 1957
Plugging completed January 6 1957
Reason for abandonment of well or producing formation

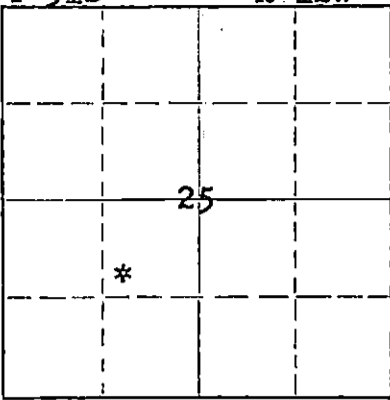

Locate well correctly on above Section Plat

If a producing well is abandoned, date of last production 19
Was permission obtained from the Conservation Division or its agents before plugging was commenced? Yes

Name of Conservation Agent who supervised plugging of this well Merle Rives
Producing formation Depth to top Bottom Total Depth of Well 4349 Feet
Show depth and thickness of all water, oil and gas formations.

OIL, GAS OR WATER RECORDS

CASING RECORD

FORMATION	CONTENT	FROM	TO	SIZE	PUT IN	PULLED OUT
				8-5/8"	152'	None
				5-1/2"	4333'	3411'

Describe in detail the manner in which the well was plugged, indicating where the mud fluid was placed and the method or methods used in introducing it into the hole. If cement or other plugs were used, state the character of same and depth placed, from feet to feet for each plug set.

Lane Wells Company set a plug at 4248' to shut off gas. Ran 4 sacks of cement on top of plug. Pulled casing up to 1600' and circulated the hole with 14 sacks of jell mud. Pulled rest of casing and bailed mud to 200'. Set a 10' rock bridge at 200', set a 10' rock bridge and ran 25 sacks of cement which filled to 125'. Mudded the hole to 35', set a rock bridge and ran 10 sacks of cement to base of cellar. Plugging completed.

Rec. 1-19-57

(If additional description is necessary, use BACK of this sheet)

Name of Plugging Contractor West Supply Co., Inc.
Address Chase, Kansas


STATE OF KANSAS, COUNTY OF SEDGWICK, ss.
Heber Beardmore (employee of owner) or (owner or operator) of the above-described well, being first duly sworn on oath, says: That I have knowledge of the facts, statements, and matters herein contained and the log of the above-described well as filed and that the same are true and correct. So help me God.

(Signature) Heber Beardmore
827 Beacon Building, Wichita, Kansas
(Address)

SUBSCRIBED AND SWORN TO before me this 18th day of January, 1957

My commission expires January 28, 1960
Leonard P. Tolle - Notary Public.

PLUGGING
FILE SEC. 25 T. 31 R. 12W
BOOK PAGE 122 LINE 13

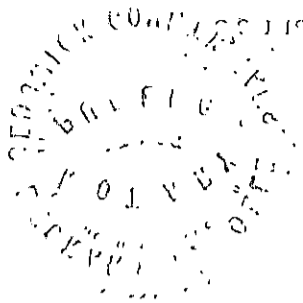

JCF

STATE CORPORATION COMMISSION

RECEIVED
STATE CORPORATION COMMISSION

JAN 17 1967

CONSERVATION DIVISION
Wichita, Kansas

STATE CORPORATION COMMISSION
WICHITA, KANSAS
RECEIVED
JAN 17 1967
CONSERVATION DIVISION
WICHITA, KANSAS

STATE CORPORATION COMMISSION

STATE CORPORATION COMMISSION

*2 copies
of Clarence*

BEARDMORE-SUTTON-WARNER-RATHBONE

#2 Phye
SW NE SW, Sec. 25-31S-12W
Barber County, Kansas

Drilled By: Beardmore Drilling Co.
Drilling Commenced: 6-7-55
Drilling Completed: 6-21-55

Casing Record:

Set 152' of 8-5/8" with 110 sacks. Cement circulated 6-7-55.
5-1/2" set at 4333' with 50 sacks. 6-21-55.

Elevation: KB 1583
DF 1580
Gr 1577

15-657-1000-0000

<u>FORMATIONS</u>	<u>DEPTH</u>
Cellar	5
Sand	55
R. Rock and Shale	500
Shale	1100
Lime	1370
Shale and Shells	1600
Shale and Lime	3430
Sand (Elgin)	3442
Shale and Lime	3580
Sand	3637

<u>FORMATIONS</u>	<u>DEPTH</u>
Sand and Lime	3700
Sand	3703
Lime and Shale	3830
Lime	4195
Lime and Shale	4275
Lime	4298
Lime and Chert	4317
Lime	4349
Rotary Total Depth	4349

<u>TOPS</u>	
Elgin	3430
Heebner	3560
Douglas Sand	3626
Lower Douglas Sand	3694

<u>TOPS</u>	
Brown Lime	3740
Lansing	3752
Mississippi	4302

- DRILL STEM TEST #1 - 3428-3442. Gas in 9 min., 180,000 c.f.g. Rec. 90' gas cut muddy salt water. BHP 1010. IF 60. FF 110.
- DRILL STEM TEST #2 - 3621-3637. 4' mud in the DST. Will make approximately 20' more and test again.
- DRILL STEM TEST #3 - 3650-3703' Shut in 20 min. Open 1 hr. Rec. 660' muddy salt water. BHP 1250. IF 70. FF 350.
- DRILL STEM TEST #4 - 4302-4317. Open 1 hr. 15 min. Shut in 20 min. Gas to surface in 55 min., too weak to measure. Rec. 35' mud. BHP 1472.
- DRILL STEM TEST #5 - 4317-4332. Open 1 hr. Shut in 20 min. Rec. 60' slightly oil and gas cut mud, 30' heavily o and g cut mud. BHP 1205.
- DRILL STEM TEST #6 - 4332-4349. Open 1 hr. Shut in 20 min. Rec. 780' oil, 240' muddy oil, 30' muddy water. BHP 1575. IF 74. FF 288.

STATE OF KANSAS }
COUNTY OF SEDGWICK } ss

I, the undersigned, being duly sworn on oath state that the above and within statement is a true and correct record and log of the well drilled on the location above-described, to the best of my knowledge and belief.

Robert J. Sutton

Subscribed and sworn to before me this 6th day of July, 1955.

Leonard P. Tolle
Notary Public

My Commission Expires:
January 28, 1956

RECEIVED
STATE CORPORATION COMMISSION
DEC 26 1956
CONSERVATION DIVISION
Wichita, Kansas

PLUGGING
SEC. 25 T. 31 R. 12W
BOOK PAGE 128 L. E. 13