


WELL PLUGGING RECORD

Give All Information Completely
Make Required Affidavit
Mail or Deliver Report to:
Conservation Division
State Corporation Commission
211 No. Broadway
Wichita, Kansas

NORTH

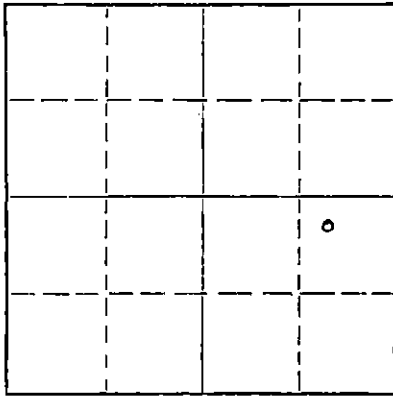

Locate well correctly on above
Section Plat

Barber County. Sec. 25 Twp. 31 Rge. 12 (E) W (W)
Location as "NE/CNW/SW" or footage from lines NW NE SE
Lease Owner Parker Petroleum
Lease Name Nuckolls Well No. 1
Office Address Box 791 Ponca City, Oklahoma
Character of Well (completed as Oil, Gas or Dry Hole) Oil
Date well completed 9/13 19 55
Application for plugging filed 6/26 19 56
Application for plugging approved 19
Plugging commenced 6/27 19 56
Plugging completed 6/30 19 56
Reason for abandonment of well or producing formation No longer commercial

If a producing well is abandoned, date of last production 5/30 19 56
Was permission obtained from the Conservation Division or its agents before plugging was commenced? Yes

Name of Conservation Agent who supervised plugging of this well
Producing formation Mississippi Depth to top 4243 Bottom 4302 Total Depth of Well 4302 Feet
Show depth and thickness of all water, oil and gas formations.

OIL, GAS OR WATER RECORDS

CASING RECORD

FORMATION	CONTENT	FROM	TO	SIZE	PUT IN	PULLED OUT
Elgin	Gas	3358		8 5/8	225	0
U/Douglas		3557		5 1/2	4300'	3067
L/Douglas	Gas	3618				
Mississippi	Oil	4243				

Describe in detail the manner in which the well was plugged, indicating where the mud fluid was placed and the method or methods used in introducing it into the hole. If cement or other plugs were used, state the character of same and depth placed, from _____ feet to _____ feet for each plug set.

Filled hole with sand to 3600'
Dumped 5 sacks cement from 3600' to 3560'
Pulled pipe
Pumped 25 sacks magcogel
Released plug
Pumped 75 sacks cement
Pumped plug to 215'
Casing full to top

(If additional description is necessary, use BACK of this sheet)

Name of Plugging Contractor Arnett Casing Pulling Company
Address Hoisington, Kansas

STATE OF Oklahoma COUNTY OF Kay, ss.
Thalia Welborn (employee of owner) or (owner or operator) of the above-described well, being first duly sworn on oath, says: That I have knowledge of the facts, statements, and matters herein contained and the log of the above-described well as filed and that the same are true and correct. So help me God.

(Signature) Thalia Welborn
Ponca City, Oklahoma (Address)

SUBSCRIBED AND SWORN TO before me this 30 day of July, 19 56

My commission expires December 1, 1959

Francis Fern Alston Notary Public.

RECEIVED
STATE CORPORATION COMMISSION

JUL 31 1956

CONSERVATION DIVISION
Wichita, Kansas

PLUGGING
FILE SEC. 25 T. 31 R. 12W
BOOK PAGE 74 LINE 39

Company - Orville H. Parker ET AL.
 Contractor - L. C. Smitherman Drilg. Co.
 Commenced - 6-10-55
 Completed - 6-25-55
 Total Depth - 4302'

Location: E/2 SE/4, Sec. 25-31S-12W,
 Barber County, Kansas.
 Elevation:
 Casing: 8 5/8" - 225' cemented w/ 175
 Skts. 5 1/2" - 4302' cemented w/
 250 Skts.

Figures Indicate Bottoms of Formations:

Depth	Formation
0 - 15	Sand
15 - 95	Red Rock
95 - 169	Shale
169 - 225	Shale & Shells
225 - 945	Red Bed & Shale
945 - 1735	Shale & Lime
1735 - 1955	Lime (Fort Riley)
1955 - 2110	Shale & Lime
2110 - 2190	Lime
2190 - 2847	Lime & Shale
2847 - 2914	Shale
2914 - 3048	Shale & Lime
3048 - 3150	Lime Sandy
3150 - 3300	Lime & Shale
3300 - 3359	Shale & Lime
3359 - 3430	Sand
3430 - 3538	Shale & Lime
3538 - 3556	Lime
3556 - 3567	Sand
3567 - 3613	Sand & Lime
3613 - 3680	Sand
3680 - 4283	Lime (K. C.)
4263 - 4282	Lime (Miss.) Cherty
4282 - 4302	Chat (Miss.)
4302 - R. T. D.	

We hereby certify the above and foregoing to be a true and correct copy of the Log on the Nickolls #1, located in the E/2 SE/4, Section 25-31S-12W, Barber County, Kansas.

L. C. SMITHERMAN DRILLING COMPANY

Joe Cain
 Joe Cain - Superintendent

Subscribed and sworn to before me this 30th day of June, 1955.

Ruth A. Carter
 Ruth A. Carter
 Notary Public

My commission expires October 23, 1958.

RECEIVED
 STATE GOVERNMENT

COMMISSIONER

PLUGGING
 FILE SEC 25 T 31 R 12W
 BOOK PAGE 74 LINE 39