


Give All Information Completely  
Make Required Affidavit  
Mail or Deliver Report to:  
Conservation Division  
State Corporation Commission  
800 Bitting Building  
Wichita, Kansas

WELL PLUGGING RECORD

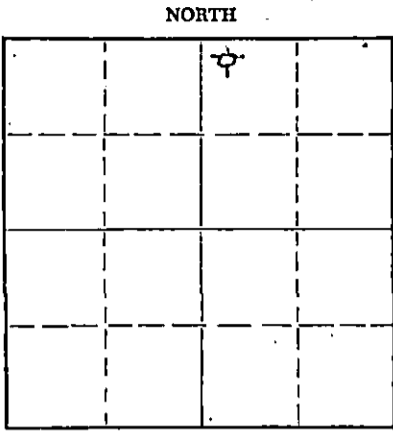

Locate well correctly on above  
Section Plat

Barber County. Sec. 30 n Twp. 31 S Rge. 12 W (E) (W)  
Location as "NE/CNW/SW" or footage from lines NW NW NE  
Lease Owner Aurora Gasoline Co.  
Lease Name Clarke Well No. 1  
Office Address Roberts Hotel - Pratt, Kansas  
Character of Well (completed as Oil, Gas or Dry Hole) Dry  
Date well completed 6-24 19 55  
Application for plugging filed 19  
Application for plugging approved 19  
Plugging commenced 6-25 19 55  
Plugging completed 6-25 19 55  
Reason for abandonment of well or producing formation

If a producing well is abandoned, date of last production 19  
Was permission obtained from the Conservation Division or its agents before plugging was commenced? Yes

Name of Conservation Agent who supervised plugging of this well Merle Rives  
Producing formation Depth to top Bottom Total Depth of Well 4680 Feet  
Show depth and thickness of all water, oil and gas formations.

OIL, GAS OR WATER RECORDS

CASING RECORD

| FORMATION | CONTENT | FROM | TO | SIZE  | PUT IN | PULLED OUT |
|-----------|---------|------|----|-------|--------|------------|
|           |         |      |    | 8 1/2 | 207    |            |
|           |         |      |    |       |        |            |
|           |         |      |    |       |        |            |
Describe in detail the manner in which the well was plugged, indicating where the mud fluid was placed and the method or methods used in introducing it into the hole. If cement or other plugs were used, state the character of same and depth placed, from feet to feet for each plug set.

Bottom plug C 200' with 1 1/2 Gallon of hulls in burlap sak & 20 sks of cement.  
Top plug C 40' with 1/4 sk hulls & 10 sks of cement

RECEIVED  
STATE CORPORATION COMMISSION

JUL 15 1955

CONSERVATION DIVISION  
WICHITA, KANSAS

Name of Plugging Contractor S. A. Berwick  
Address Great Bend, Kansas

STATE OF KANSAS, COUNTY OF SEDGWICK ss.  
Leonard Olds (employee of owner) or (owner or operator) of the above-described well, being first duly sworn on oath, says: That I have knowledge of the facts, statements, and matters herein contained and the log of the above-described well as filed and that the same are true and correct. So help me God.

(Signature) Leonard Olds (Leonard Olds)

802 Union National Bank Building, Wichita, Ks.  
(Address)

SUBSCRIBED AND SWORN TO before me this 15<sup>th</sup> day of July, 1955.

My commission expires October 23, 1957

Frances C. Newlon  
Notary Public.

PLUGGING  
FILE SEC 30 T 31 R 12 W  
BOOK PAGE 129 LINE 23

RECEIVED  
JUL 5 1955

AURORA GASOLINE COMPANY

AURORA-TULSA, OKLAHOMA

Clarke # 1  
Total Depth: 4680'  
Commenced R.D.: 6-7-55  
Completed R.D.: 6-25-55

NW NW NE Sec. 30-31S-12W  
Barber County, Kansas  
Elevation: 1618' RB 1613' GL  
Initial Prod: D.H.  
Contractor: S.A. Berwick  
Drilling Company

15-007-60180-0000

| Strata                | Depth | Depth |
|-----------------------|-------|-------|
| Surface Soil and Sand | 0-    | 40    |
| Red Rock              | 40-   | 210   |
| Red Bed               | 210-  | 575   |
| Shale                 | 575-  | 650   |
| Shale and Shells      | 650-  | 1373  |
| Anhydrate             | 1373- | 1411  |
| Shale and Shells      | 1411- | 1460  |
| Shale and Lime        | 1460- | 1660  |
| Lime                  | 1660- | 2090  |
| Lime and Shale        | 2090- | 2190  |
| Shale                 | 2190- | 3370  |
| Lime and Shale        | 3370- | 3390  |
| Lime                  | 3390- | 3780  |
| Lime and Chert        | 3780- | 4251  |
| Lime                  | 4251- | 4275  |
| Lime and Chert        | 4275- | 4323  |
| Lime                  | 4323- | 4360  |
| Lime and Shale        | 4360- | 4430  |
| Lime                  | 4430- | 4495  |
| Lime and Shale        | 4495- | 4550  |
| Sand and Shale        | 4550- | 4595  |
| Lime                  | 4595- | 4680  |

I hereby certify the above a true and correct log of said well as reflected by the daily drilling report.

COMMISSION  
JUL 15 1955  
OBSERVATION DIVISION  
Wichita, Kansas

S.A. BERWICK DRILLING COMPANY

By S.A. Berwick

Signed and sworn to in my presence this 30 day of June, 1955, by S.A. Berwick, Owner of the S.A. Berwick Drilling Company.

John W. Poon  
Notary Public

My Commission Expires: 4-11-59

PLUGGING  
WELL SEC 30-31 R 126  
PAGE 129 LINE 23