

STATE CORPORATION COMMISSION OF KANSAS
OIL & GAS CONSERVATION DIVISION
WELL COMPLETION OR RECOMPLETION FORM
ACO-1 WELL HISTORY
DESCRIPTION OF WELL HISTORY

S.C

API No. 15- 189-21175-00-00
COUNTY STEVENS
East
NW SW Sec 29 Twp 34S Rge 37 X West

Operator: License # 5208
Name MOBIL OIL CORPORATION
Address P.O. BOX 5444
City/State/Zip DENVER, COLORADO 80217

1650 Ft North from Southeast Corner of Section
4628 Ft West from Southeast Corner of Section
(Note: Locate well in section plat below)

Purchaser NA

Lease Name MARY F. SPRINGER WELL # 1

Field Name WILDCAT

Operator Contact Person B. R. MAYNARD
Phone (303) 298-2069


Producing Formation ST. LOUIS

Contractor: License # 9137
Name UNIT DRILLING & EXPLORATION CO.

Elevation: Ground 3162' KB 3178'

Wellsite Geologist D. OSWEILER
Phone (303) 298-2391

SECTION PLAT

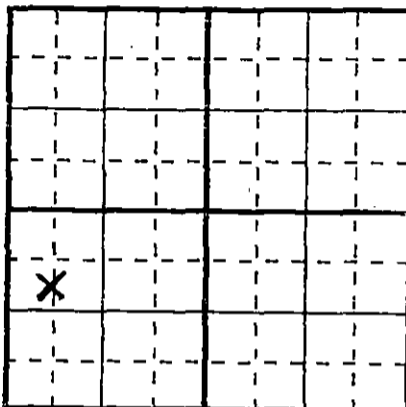

Designate Type of Completion
XX New Re-Entry Workover
Oil SWD XX Temp Abd
Gas Inj Delayed Comp.
Dry Other (Core, Water Supply, etc.)

WATER SUPPLY INFORMATION

If OHWO: old well info as follows;
Operator
Well Name
Comp. Date

Disposition of Produced Water: Disposal
Docket # TA'D Repressuring

WELL HISTORY

Drilling Method:
XX Mud Rotary Air Rotary Cable
4-12-88 4-22-88 TA'D 6-8-88
Spud Date Date Reached TD Completion Date

6930' 3150'
Total Depth PBDT

Amount of Surface Pipe Set and Cemented at 1768 feet
Multiple Stage Cementing Collar Used? XX Yes No
If yes, show depth set 3310 feet
If alternate 2 completion, cement circulated
from feet depth to w/ SX cat
Cement Company Name
Invoice #

Questions on this portion of ACO-1 call:
Water Resources Board (913) 296-3717

Source of Water:
Division of Water Resources Permit# T88-187

XX Groundwater 1815 Ft. North from Southeast Corner
(well) 4643 Ft. West from Southeast Corner of
Sec 29 Twp 34S Rge 37 East X West

Surface Water Ft. North from Southeast Corner
(Stream, pond etc) Ft. West from Southeast Corner
Sec Twp Rge East West

Other (explain)

(purchased from city, R.W.D. #)

INSTRUCTIONS: This form shall be completed in triplicate and filed with the Kansas Corporation Commission, 1000 Colorado Derby Building, Wichita, Kansas 67202, within 120 days of the spud date of any well. Rule 82-3-130, 82-3-106 apply.

Information on side two of this form will be held confidential for a period of 12 months if requested in writing and submitted with the form. See rule 82-3-107 for confidentiality in excess of 12 months. One copy of all wireline logs and drillers time log shall be attached with this form. Submit cp-111 from with all temporarily abandoned wells.

RECEIVED
STATE CORPORATION COMMISSION
JUL 20 1988
OIL & GAS CONSERVATION DIVISION
Wichita, Kansas

All requirements of statutes, rules and regulations promulgated to regulate the oil and gas industry have been fully complied with and the statements herein are complete and correct to the best of my knowledge.

Signature B. R. Maynard B. R. MAYNARD
Title REGULATORY COMPLIANCE MANAGER Date 7-26-88

Subscribed and sworn to before me this 26th day of July 1988
Notary Public Clara M. Biddell

Date Commission Expires February 14, 1992

K.C.C. OFFICE USE ONLY
Letter of Confidentiality Attached
Wireline Log Received
Drillers Timelog Received
Distribution
KCC SWD/Rep NGPA
KGS Plug Other (Specify)
7-29-88