


STATE OF KANSAS  
STATE CORPORATION COMMISSION  
Give All Information Completely  
Make Required Affidavit  
Mail or Deliver Report to:  
Conservation Division  
State Corporation Commission  
211 No. Broadway  
Wichita, Kansas

WELL PLUGGING RECORD

Sumner County, Sec. 3 Twp. 30S Rge. 4 (E) (XX)  
Location as "NE/CNW/SW" or footage from lines NE SW SW  
Lease Owner Stelbar Oil Corporation, Inc.  
Lease Name Rowan Well No. 1 (Washdown)  
Office Address 310 Petroleum Building  
Character of Well (completed as Oil, Gas or Dry Hole) Dry Hole  
Date well completed July 27, 19 63  
Application for plugging filed July 27, 19 63  
Application for plugging approved July 27, 19 63  
Plugging commenced July 27, 19 63  
Plugging completed July 27, 19 63  
Reason for abandonment of well or producing formation Dry

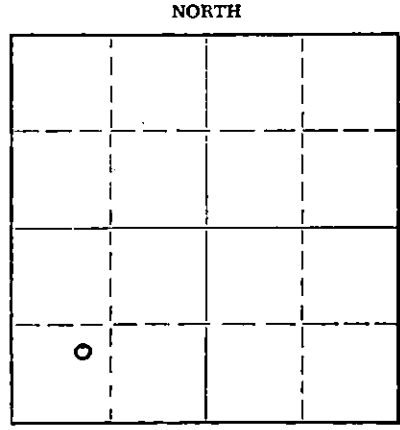

Locate well correctly on above Section Plat

If a producing well is abandoned, date of last production 19  
Was permission obtained from the Conservation Division or its agents before plugging was commenced? Yes

Name of Conservation Agent who supervised plugging of this well H. E. Hess  
Producing formation Depth to top Bottom Total Depth of Well 4545 Feet  
Show depth and thickness of all water, oil and gas formations.

OIL, GAS OR WATER RECORDS				CASING RECORD			
FORMATION	CONTENT	FROM	TO	SIZE	PUT IN	PULLED OUT	

Describe in detail the manner in which the well was plugged, indicating where the mud fluid was placed and the method or methods used in introducing it into the hole. If cement or other plugs were used, state the character of same and depth placed, from feet to feet for each plug set.  
Plugged hole with mud to 300'. Set plug, ran 1/2 sack hulls and 20 sacks cement.  
Plugged hole with mud to 35', set plug and ran 1/2 sack hulls and 8 sacks cement.  
Ran 2 sacks cement in rat hole


RECEIVED  
STATE CORPORATION COMMISSION  
AUG 23 1963  
8-23-63  
CONSERVATION DIVISION  
Wichita, Kansas


(If additional description is necessary, use BACK of this sheet)  
Name of Plugging Contractor Stelbar Oil Corporation, Inc.  
Address 310 Petroleum Bldg., Wichita 2, Kansas

STATE OF KANSAS, COUNTY OF SEDGWICK, ss.  
Jerry E. Shawver (employee of owner) or (owner or operator) of the above-described well, being first duly sworn on oath, says: That I have knowledge of the facts, statements, and matters herein contained and the log of the above-described well as filed and that the same are true and correct. So help me God.

(Signature) Jerry E. Shawver  
310 Petroleum Building, Wichita 2, Kansas  
(Address)

SUBSCRIBED AND SWORN to before me this 20th day of August, 19 63  
My commission expires May 7, 1966.  
Talia Zuhars  
Talia Zuhars Notary Public.

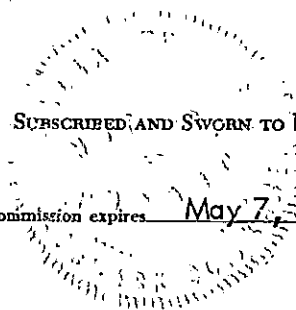

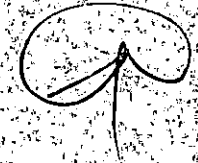LOG

Farm: Rowan  
 Well No. 1 (Washdown)  
 NE SW SW Sec. 3-30S-4W  
 Sumner County, Kansas

Owner: Stelbar Oil Corporation, Inc.  
 Contractor: Stelbar Oil Corporation, Inc.  
 Drilling Commenced: 7-22-63  
 Drilling Completed: 7-27-63

Elevation	1413 RB
	1410 DF
	1408 GL
latan	3026
Stalnaker	3079
Kansas City	3352
Base Kansas City	3573
Marmaton	3647
Cherokee	3785
Mississippi	3979
Simpson	4410
Arbuckle	4505
Total Depth	4545

Plugged hole with mud to 300'. Set plug, ran 1/2 sack hulls and 20 sacks cement.  
 Plugged hole with mud to 35', set plug and ran 1/2 sack hulls and 8 sacks cement.  
 Ran 2 sacks cement in rat hole.

RECEIVED  
 STATE CORPORATION COMMISSION

AUG 23 1963

CONSERVATION DIVISION  
 Wichita, Kansas