


STATE OF KANSAS
STATE CORPORATION COMMISSION

WELL PLUGGING RECORD

Give All Information Completely
Make Required Affidavit
Mail or Deliver Report to
Conservation Division
State Corporation Comm.
245 North Water
Wichita, KS 67202

Sumner County, Sec. 31 Twp. 30 Rge. 2 E/W
Location as "NE/CNW $\frac{1}{4}$ SW $\frac{1}{4}$ " or footage from lines _____
C N/2 NW NW
Lease Owner Stelbar Oil Corporation
Lease Name Leddy #1 Well No. _____
Office Address Wichita, Kansas 67202
Character of Well (Completed as Oil, Gas or Dry Hole) _____

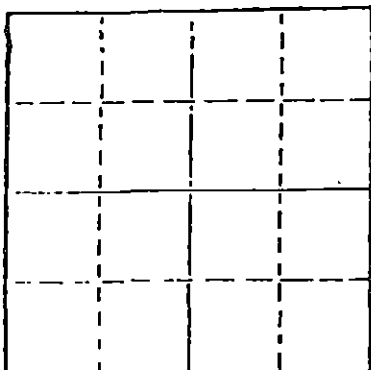

Locate well correctly on above
Section Plat

Date Well completed _____ 19____
Application for plugging filed _____ 19____
Application for plugging approved _____ 19____
Plugging commenced 9/21/79 _____ 19____
Plugging completed 9/25/79 _____ 19____
Reason for abandonment of well or producing formation _____
depleted

If a producing well is abandoned, date of last production _____ 19____

Was permission obtained from the Conservation Division or
its agents before plugging was commenced? yes

Name of Conservation Agent who supervised plugging of this well Barnett
Producing formation _____ Depth to top _____ Bottom _____ Total Depth of Well 2955
Show depth and thickness of all water, oil and gas formations.

OIL, GAS OR WATER RECORDS

CASING RECORD

FORMATION	CONTENT	FROM	TO	SIZE	PUT IN	PULLED OUT
				8-5/8	267	none
				4 1/2"	2954	2282'

Describe in detail the manner in which the well was plugged, indicating where the mud fluid
was placed and the method or methods used in introducing it into the hold. If cement or other
plugs were used, state the character of same and depth placed, from _____ feet to
_____ feet for each plug set.

Sanded to 2800' and ran 4 sacks cement. Shot pipe at 2615', 2410', 2270', pulled 60
joints. Mudded hole to 310', set 20' rock bridge and filled hole with 4 yards ready mix,
from 290' to base of cellar.

PLUGGING COMPLETE.

RECEIVED
STATE CORPORATION COMMISSION
10-1-1979
OCT - 1 1979

(If additional description is necessary, use BACK of this sheet)

Name of Plugging Contractor KELSO CASING PULLING
CHASE, KANSAS

CONSERVATION DIVISION
Wichita, Kansas

STATE OF KANSAS COUNTY OF RICE, ss.
R. DARRELL KELSO (employee of owner) or (owner or operator)
of the above-described well, being first duly sworn on oath, says: That I have knowledge of
the facts, statements, and matters herein contained and the log of the above-described well
as filed and that the same are true and correct. So help me God.

(Signature) R. Darrell Kelso
CHASE, KANSAS

(Address)

SUBSCRIBED AND SWORN TO before me this 27th day of Sept., 19 79

Margaret Melcher
Notary Public.

My commission expires _____



DRILLERS LOG

OPERATOR: Stelbar Oil Corporation; 200 W. Douglas; Suite 950; Wichita, KS 67201
CONTRACTOR: White & Ellis Drilling, Inc., Box 448, El Dorado, Kansas 67042

Lease Name Leddy Well No. 1

Sec. 31 T. 30S R. 2W Spot CN/2 NW NW

County Sumner State Kansas Elevation _____

Casing Record:

Surface: 8 5/8" @ 267' with 175 Sxs.

Production: 4 1/2" @ 2954' with 80 Sxs.

Type Well: Oil Total Depth 2955' K.B.

Drilling Commenced: 6-10-78 Drilling Completed 6-16-78

Formation	From	To	Tops
Cellar	0	7	Anhydrite 530
Sandy Shale	7	50	Topeka 2147
Shale	50	530	Stalnaker 2895
Anhydrite & Shale	530	735	
Shale & Lime (Stks)	735	1135	
Shale & Lime	1135	1450	
Shale & Lime (Stks)	1450	1925	
Shale & Lime	1925	2079	
Lime	2079	2095	
Shale & Lime	2095	2122	
Shale	2122	2147	
Lime	2147	2533	
Shale & Lime	2533	2636	
Shale	2636	2823	
Lime	2823	2826	
Sand	2826	2838	
Shale	2838	2895	
Sand	2895	2898	
Sand & Shale	2898	2940	
Shale	2940	2955	

RECEIVED
STATE CORPORATION COMMISSION

SEP 21 1979

CONSERVATION DIVISION
Wichita, Kansas

COMPLETION RECORD

Liner Record: Size _____ From _____ To _____

Cementing Record: _____ Sacks _____

Perforating Record:

Formation	Perforated Interval	Number Shots

Initial Production: _____

Electric Log _____ Type and Depths Covered _____

