

STATE OF KANSAS
STATE CORPORATION COMMISSION


WELL PLUGGING RECORD

Checks 2W

Give All Information Completely
Make Required Affidavit
Mail or Deliver Report to
Conservation Division
State Corporation Comm.
245 North Water
Wichita, KS 67202

Sumner County. Sec. 29 Twp. 30 Rge. 2 E/W
Location as "NE/CNW $\frac{1}{4}$ SW $\frac{1}{4}$ " or footage from lines
C N/2 SE/4

Lease Owner Colonial Corporation
Lease Name McIntrye Well No. 1
Office Address 0201 College Winfield, Kansas 67156
Character of Well (Completed as Oil, Gas or Dry Hole) Dry Hole

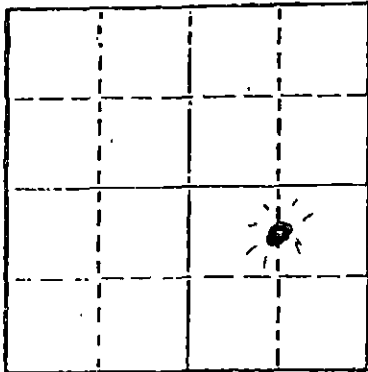

Locate well correctly on above
Section Plot

Date Well completed 19
Application for plugging filed 19
Application for plugging approved 19
Plugging commenced May 11 1981
Plugging completed May 11 1981
Reason for abandonment of well or producing formation
No producing formation

If a producing well is abandoned, date of last production
None 19

Was permission obtained from the Conservation Division or
its agents before plugging was commenced? yes

Name of Conservation Agent who supervised plugging of this well Carl Barnett
Producing formation None Depth to top Bottom Total Depth of Well 3830'
Show depth and thickness of all water, oil and gas formations.

OIL, GAS OR WATER RECORDS

CASING RECORD

FORMATION	CONTENT	FROM	TO	SIZE	PUT IN	PULLED OUT

Describe in detail the manner in which the well was plugged, indicating where the mud fluid was placed and the method or methods used in introducing it into the hold. If cement or other plugs were used, state the character of same and depth placed, from 265' feet to 40 feet for each plug set. Mud to 265', plug 35 sx, mud to 40', plug 10 sx done at 9:00 P.M.

RECEIVED
STATE CORPORATION COMMISSION

(If additional description is necessary, use BACK of this sheet)
Name of Plugging Contractor Reynolds Drilling Co., Inc. MAY 19 1981 5-19-81

CONSERVATION DIVISION
Wichita, Kansas

STATE OF KANSAS COUNTY OF COWLEY, ss.
Earl R. Gilley (employee of owner) or (owner or operator)
of the above-described well, being first duly sworn on oath, says: That I have knowledge of the facts, statements, and matters herein contained and the log of the above-described well as filed and that the same are true and correct. So help me God.

(Signature) Earl R. Gilley
0201 College, Winfield, Kansas 67156
(Address)

SUBSCRIBED AND SWORN TO before me this 15th day of May, 19 81

Lucile C. Mathews
Notary Public.

My commission expires _____

LUCILE C. MATHEWS
STATE NOTARY PUBLIC
Cowley County, Kansas
My Appointment Expires:
June 25, 1984