


STATE OF KANSAS
STATE CORPORATION COMMISSION

WELL PLUGGING RECORD

Give All Information Completely
Make Required Affidavit
Mail or Deliver Report to
Conservation Division
State Corporation Comm.
245 North Water
Wichita, KS 67202

Sumner County. Sec. 25 Twp. 30S Rge. 2W E/W
Location as "NE/CNW $\frac{1}{4}$ /SW $\frac{1}{4}$ " or footage from lines
SE NW SE

Lease Owner Falcon Exploration
Lease Name Dombaugh Well No. 1
Office Address 1521 KSB&T Building Wichita, Kansas
Character of Well (Completed as Oil, Gas or Dry Hole)
dry hole
Date Well completed 3-6-82 19
Application for plugging filed 3-6-82 19
Application for plugging approved 3-6-82 19
Plugging commenced 3-6-82 19
Plugging completed 3-6-82 19
Reason for abandonment of well or producing formation

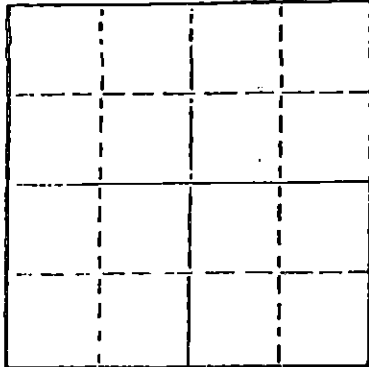

Locate well correctly on above
Section Plot

If a producing well is abandoned, date of last production 19

Was permission obtained from the Conservation Division or
its agents before plugging was commenced? yes

Name of Conservation Agent who supervised plugging of this well Tim Galliger
Producing formation Depth to top Bottom Total Depth of Well 3790
Show depth and thickness of all water, oil and gas formations.

OIL, GAS OR WATER RECORDS

CASING RECORD

FORMATION	CONTENT	FROM	TO	SIZE	PUT IN	PULLED OUT
Surface		0	487	8 5/8	487	0

Describe in detail the manner in which the well was plugged, indicating where the mud fluid was placed and the method or methods used in introducing it into the hold. If cement or other plugs were used, state the character of same and depth placed, from feet to feet for each plug set.

Mud to 500, plug & 30 Sx
Mud to 250, plug & 20 Sx
mud to 60, plug & 20 Sx
Rat Hole plugged w/5 Sx

RECEIVED
STATE CORPORATION COMMISSION
4-16-1982
APR 16 1982

RECEIVED
STATE CORPORATION COMMISSION
APR 16 1982

CONSERVATION DIVISION
Wichita, Kansas

CONSERVATION DIVISION
Wichita, Kansas

(If additional description is necessary, use BACK of this sheet)

Name of Plugging Contractor Allied Cementing

STATE OF Kansas COUNTY OF Sedgwick, ss.
Timothy E. Brandt (employee of owner) or (owner or operator)
of the above-described well, being first duly sworn on oath, says: That I have knowledge of the facts, statements, and matters herein contained and the log of the above-described well as filed and that the same are true and correct. So help me God.

(Signature)

1200 Douglas Building Wichita, Ks.
(Address)

SUBSCRIBED AND SWORN TO before me this 12th day of March, 1982

Notary Public.

My commission expires 11-29-82