


All Information Completely  
Make Required Affidavit  
Mail or Deliver Report to:  
Conservation Division  
State Corporation Commission  
800 Bittling Building  
Wichita, Kansas

WELL PLUGGING RECORD

15-173-60441-0000

NORTH

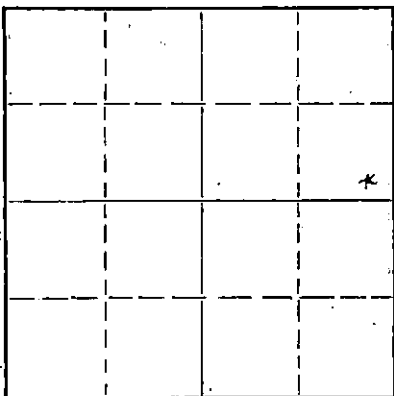

Locate well correctly on above  
Section Plat

Sedgwick County, Sec. 32 Twp. 28S Rge. (E) 2 (W)  
Location as "NE/CNW/SE" or footage from lines SE 1/4 SE 1/4 NW 1/4  
Lease Owner O. A. Sutton  
Lease Name Pelz Well No. 1  
Office Address Insurance Building, Wichita, Kansas  
Character of Well (completed as Oil, Gas or Dry Hole) Dry Hole  
Date well completed December 11, 1954  
Application for plugging filed December 11, 1954  
Application for plugging approved December 11, 1954  
Plugging commenced December 11, 1954  
Plugging completed December 11, 1954  
Reason for abandonment of well or producing formation Dry Hole

If a producing well is abandoned, date of last production - - - 19  
Was permission obtained from the Conservation Division or its agents before plugging was com-  
menced? Yes

Name of Conservation Agent who supervised plugging of this well W. G. Buffington  
Producing formation Depth to top Bottom Total Depth of Well 4235 Feet  
Show depth and thickness of all water, oil and gas formations.

OIL, GAS OR WATER RECORDS

CASING RECORD

FORMATION	CONTENT	FROM	TO	SIZE	PUT IN	PULLED OUT
		0	298	8-5/8"	298	- - -

Describe in detail the manner in which the well was plugged, indicating where the mud fluid was placed and the method or methods used in introducing it into the hole. If cement or other plugs were used, state the character of same and depth placed, from feet to feet for each plug set.

Filled hole with heavy mud from 4235 feet to 298 feet. Set wooden plug at 298 feet and dumped 1/2 sack of hulls and 15 sacks of cement on plug. Completed filling hole with heavy mud to 40 feet. Set second wooden plug at 40 feet. Dumped 1/2 sack of hulls and 10 sacks of cement on plug to fill to bottom of cellar.

12-18-54

(If additional description is necessary, use BACK of this sheet)


Name of Plugging Contractor Barnett Drilling, Inc.  
Address 409 First National Bank Building, Wichita 2, Kansas

STATE OF Kansas, COUNTY OF Sedgwick ss.  
F. R. Stubblefield (employee of owner) or (owner or operator) of the above-described well, being first duly sworn on oath, says: That I have knowledge of the facts, statements, and matters herein contained and the log of the above-described well as filed and that the same are true and correct. So help me God.

(Signature) F. R. Stubblefield  
409 First National Bank Building, Wichita, Kansas  
(Address)

SUBSCRIBED AND SWORN TO before me this 16th day of December, 1954

My commission expires February 27, 1956. Mildred T. Willis Notary Public.

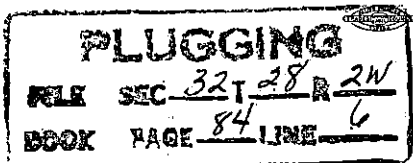

BARNETT DRILLING, INC.

LOG OF PELZ WELL NO. 1

15-173-0044-0000

SE $\frac{1}{4}$  SE $\frac{1}{4}$  NW $\frac{1}{4}$  SECTION 32-28S-2W, SEDGWICK COUNTY, KANSAS

Commenced: 11-19-54

Completed: 12-14-54


Formation	From	To	Remarks
Clay	0	40	
Sand	40	50	
Sand and Shale	50	80	
Shale and Shells	80	160	
Sand	160	180	
Shale and Shells	180	298	Set 8-5/8" surface pipe at 298 feet; cemented with 200 sacks.
Shale and Lime	298	855	
Lime	855	985	
Shale and Lime	985	2080	
Lime	2080	2170	
Shale and Lime	2170	2395	
Lime	2395	2735	
Shale and Sand	2735	2800	
Lime	2800	2920	
Shale and Lime	2920	3040	
K. C. Lime	3040	3050	
Lime	3050	3240	
Shale	3240	3320	
Lime	3320	3415	
Shale and Lime	3415	3665	
Lime	3665	3970	
Shale and Lime	3970	4010	
Lime	4010	4050	
Shale and Lime	4050	4110	
Lime	4110	4137	
Sand	4137	4145	
Sand and Shale	4145	4171	
Lime and Sand	4171	4186	
Lime	4186	4205	
Lime and Sand	4205	4215	
Lime	4215	4235	
Total Depth		4235	Dry and Abandoned.

CERTIFICATE

I, F. R. Stubblefield, of Barnett Drilling, Inc., certify that, to the best of my knowledge and belief, the above is a true and correct log of the Pelz Well No. 1, located in the SE $\frac{1}{4}$  SE $\frac{1}{4}$  NW $\frac{1}{4}$  of Section 32-28S-2W, Sedgwick County, Kansas.

*F. R. Stubblefield*

Subscribed and sworn to before me, in and for the County of Sedgwick, State of Kansas, this 16th day of December, 1954.

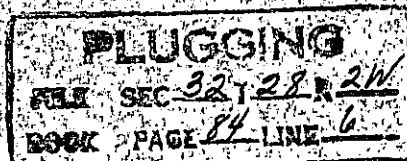

*William F. Willes*

My commission expires February 27, 1956.