


WELL PLUGGING RECORD

Give All Information Completely
Make Required Affidavit
Mail or Deliver Report to:
Conservation Division
State Corporation Commission
211 No. Broadway
Wichita, Kansas

Sedgwick County, Sec. 31 Twp. 28S Rge. 2 (X) W (W)

Location as "NE/CNW/SW" or footage from lines NE NE SW/4
Lease Owner E. K. Carey Drilling Co., Inc.
Lease Name Pauly Well No. 1
Office Address Box 620, McPherson, Kansas
Character of Well (completed as Oil, Gas or Dry Hole) Dry hole
Date well completed 3-10-56 19
Application for plugging filed 3-10-56 19
Application for plugging approved 3-10-56 19
Plugging commenced 2 AM 3-11-56 19
Plugging completed 4 AM 3-11-56 19
Reason for abandonment of well or producing formation Dry

NORTH

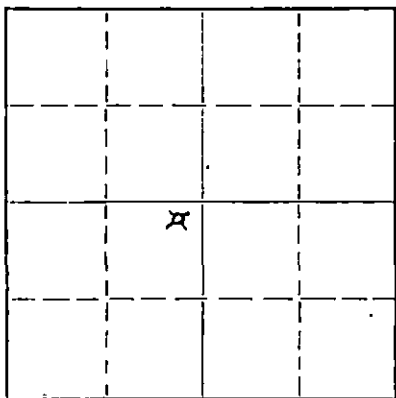

Locate well correctly on above Section Plat

If a producing well is abandoned, date of last production _____ 19
Was permission obtained from the Conservation Division or its agents before plugging was commenced? Yes

Name of Conservation Agent who supervised plugging of this well Mr. Ruel Durkee, McPherson, Kansas
Producing formation _____ Depth to top _____ Bottom _____ Total Depth of Well 3812 Feet
Show depth and thickness of all water, oil and gas formations.

OIL, GAS OR WATER RECORDS

CASING RECORD

FORMATION	CONTENT	FROM	TO	SIZE	PUT IN	PULLED OUT
				8-5/8	250'	None

Describe in detail the manner in which the well was plugged, indicating where the mud fluid was placed and the method or methods used in introducing it into the hole. If cement or other plugs were used, state the character of same and depth placed, from 230-215 feet to 20-5 feet for each plug set.

Gunned pits and circulated heavy mud on bottom, layed down half of drill pipe. Circulated heavy mud half way out, layed down all but 7 jts. drill pipe. Ran measureing line and mud was at 134'. Put plug at 230' to make bridge, made bridge with plug and rocks to hold weight of 7 jts. drill pipe. Mixed 15 sacks cement and pumped thru 7 jts. drill pipe by Halliburton. Ran measureing line and filled with heavy mud to 25'. Put plug there and mixed 5 sacks cement and filled to bottom of cellar floor. Through plugging at 4 A.M.

(If additional description is necessary, use BACK of this sheet)

Name of Plugging Contractor E. K. Carey Contractor
Address Box 620, McPherson, Kansas


STATE OF Kansas, COUNTY OF McPherson, ss.
Arland Bruce (employee of owner) or (owner or operator) of the above-described well, being first duly sworn on oath, says: That I have knowledge of the facts, statements, and matters herein contained and the log of the above-described well as filed and that the same are true and correct. So help me God.

(Signature) Arland Bruce
Box 620, McPherson, Kansas
(Address)

SUBSCRIBED AND SWORN TO before me this 12th day of March, 19 56

My commission expires November 13, 1956

[Signature]
Notary Public.
STATE OF KANSAS
MAR 13 1956 3-13-56
CONSERVATION DIVISION
Wichita, Kansas

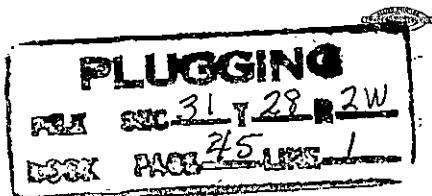

ROTARY DRILLER'S LOG

E. K. Carey Drilling Co., Inc.
Box 620
McPherson, Kansas

1395 K.B.
Elevation: 1392 D.F.
1389 Gr.

Pauly #1

C, NE NE SW/4
Sec. 31-28S-2W,
Sedgwick County, Kansas

Casing Record:
8-5/8" @ 250' w/140' sks.
Pozmix and 300# cc.

Well Commenced: 2-27-56
Well Completed: 3-11-56 D & A

Contractor; E. K. Carey, Contractor, Box 620, McPherson, Kansas, Rig #1
Geologist: Don Hollar, E. K. Carey Drlg. Co. 815 Central Bldg. Wichita

Figures Indicate Bottom of Formation K. B.

Base and cellar	8
Sand	30
Shale and shells	550
Lime and shale	720
Shale and salt	800
Lime and shale	1210
Shale and lime	1840
Lime and shale	2390
Shale and lime	2850
Sand	2950
Sand and lime	2990
Shale and shells	3090
Shale and lime	3118
Lime	3325
Lime and shale	3405
Lime	3470
Lime and shale	3590
Shale and lime	3646
Shale	3736
Lime (Miss.)	3812 TD

Geologist Tops:	
Lansing	3118
Miss.	3736
Rotary Total Depth	3812

This is to certify that the above information is to the best of my knowledge true and correct.

SUBSCRIBED AND SWORN to before me this 12th day of March, 1956.

E. K. CAREY CONTRACTOR

RECEIVED BY Herbert Rhoton
 STATE OF KANSAS MISSOURI
 CONSERVATION DIVISION
 WICHITA, KANSAS
C. Springer NP

My Commission Expires: November 13, 1956

PLUGGING
 FILE SEC 31 T28 R2W
