


STATE OF KANSAS
STATE CORPORATION COMMISSION

WELL PLUGGING RECORD

Give All Information Completely
Make Required Affidavit
Mail or Deliver Report to
Conservation Division
State Corporation Comm.
245 North Water
Wichita, KS 67202

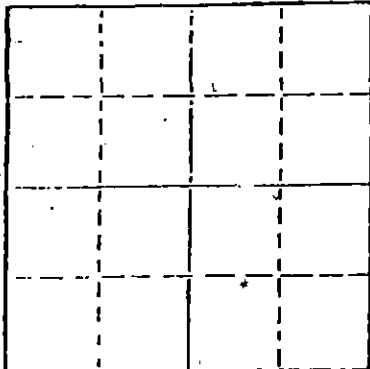

Locate well correctly on above
Section Plot

Sedgwick County. Sec. 11 Twp. 28S Rge. 2W E/W
Location as "NE/CNW1SW1" or footage from lines

NE NW NE
Lease Owner Voth Oil Company
Lease Name Weber Well No. 41
Office Address Route # 1 Goddard, Kansas
Character of Well (Completed as Oil, Gas or Dry Hole)

Dry Hole
Date Well completed 8/23/78 19
Application for plugging filed 8/23/78 19
Application for plugging approved 8/23/78 19
Plugging commenced 8/23/78 19
Plugging completed 8/23/78 19
Reason for abandonment of well or producing formation

Dry Hole
If a producing well is abandoned, date of last production 19

Was permission obtained from the Conservation Division or
its agents before plugging was commenced? yes

Name of Conservation Agent who supervised plugging of this well Buford H. Welch
Producing formation Depth to top Bottom Total Depth of Well 656
Show depth and thickness of all water, oil and gas formations.

OIL, GAS OR WATER RECORDS

CASING RECORD

FORMATION	CONTENT	FROM	TO	SIZE	PUT IN	PULLED OUT
Surface				8 5/8"	211'	none

Describe in detail the manner in which the well was plugged, indicating where the mud fluid
was placed and the method or methods used in introducing it into the hold. If cement or other
plugs were used, state the character of same and depth placed, from feet to
feet for each plug set.

Fluid to 60 feet; 20 sax. of cement. Plug to 40 feet; 10 sax. of cement.
3 sax. of cement in rat hole.

RECEIVED
STATE CORPORATION COMMISSION

SEP 11 1978

(If additional description is necessary, use back of this sheet)

Name of Plugging Contractor Dunbar Drilling Inc.
5252 North Broadway Wichita, Kansas 67219

STATE OF Kansas COUNTY OF Sedgwick, ss.
W. P. Simmons (employee of owner) or (owner or operator)
of the above-described well, being first duly sworn on oath, says: That I have knowledge of
the facts, statements, and matters herein contained and the log of the above-described well
as filed and that the same are true and correct. So help me God.

(Signature)

(Address)

SUBSCRIBED AND SWORN TO before me this 8th day of September, 1978

My commission expires Jan. 9, 1982

Susan I. McClellan Notary Public.



15-173-20188-0000

DUNBAR DRILLING INC.

5252 NORTH BROADWAY

WICHITA, KANSAS 67219

(316) 832-0501

COMPANY

VOTH OIL COMPANY

FARM

Weber

WELL

No. 1

LOCATION

(first hole)

NE NW NE Section 11-28S-2W

Sedgwick County, Kansas

CASING RECORD

8 5/8" @ 211'/175 sax.

Dry & Abandoned

COMMENCED

8/20/78

COMPLETED

8/23/78

DRILLING CONTRACTOR

DUNBAR DRILLING INC.

5252 NORTH BROADWAY

WICHITA, KANSAS 67219

DRILLERS LOG

0-7	soil
299	shale
608	lime with shale and sand
656	shale
656	R. T. D. (skid rig)

RECEIVED
STATE CORPORATION COMMISSION

SEP 11 1978

CONSERVATION DIVISION
Wichita, Kansas