


STATE OF KANSAS  
STATE CORPORATION COMMISSION

15-173-20175-0000  
WELL PLUGGING RECORD

Give All Information Completely  
Make Required Affidavit  
Mail or Deliver Report to  
Conservation Division  
State Corporation Comm.  
245 North Water  
Wichita, KS 67202

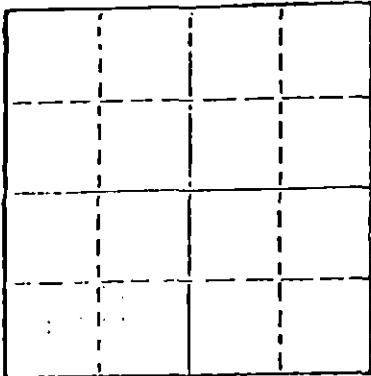

Locate well correctly on above  
Section Plot

Sedgwick County. Sec. 11 Twp. 28S Rge. 2 NE/W  
Location as "NE/CNW $\frac{1}{4}$ SW $\frac{1}{4}$ " or footage from lines  
SW NE SW  
Lease Owner Rains & Williamson Oil Co., Inc.  
Lease Name Thome Well No. #1  
Office Address 435 Page Court, 220 W. Douglas, Wichita, Ks.  
Character of Well (Completed as Oil, Gas or Dry Hole)

Dry Hole  
Date Well completed 12-22-77 19  
Application for plugging filed 12-22-77 19  
Application for plugging approved 12-22-77 19  
Plugging commenced 12-22-77 19  
Plugging completed 12-22-77 19  
Reason for abandonment of well or producing formation  
Commercial quantities of oil not found  
If a producing well is abandoned, date of last production 19

Was permission obtained from the Conservation Division or  
its agents before plugging was commenced? Yes

Name of Conservation Agent who supervised plugging of this well Carl Barnette  
Producing formation Depth to top Bottom Total Depth of Well 3598'  
Show depth and thickness of all water, oil and gas formations.

OIL, GAS OR WATER RECORDS

CASING RECORD

FORMATION	CONTENT	FROM	TO	SIZE	PUT IN	PULLED OUT
				8 5/8"	483'	None

Describe in detail the manner in which the well was plugged, indicating where the mud fluid  
was placed and the method or methods used in introducing it into the hold. If cement or other  
plugs were used, state the character of same and depth placed, from feet to  
feet for each plug set.

RECEIVED  
STATE CORPORATION COMMISSION

JAN 12 1978

CONSERVATION DIVISION  
Wichita, Kansas

Plug @ 495' w/30 sx.  
Plug @ 40' w/10 sx.  
Rat Hole 2 sx.

(If additional description is necessary, use BACK of this sheet)

Name of Plugging Contractor Rains & Williamson Oil Co., Inc.

STATE OF Kansas COUNTY OF Sedgwick, ss.  
Wilson Rains, President of Rains & Williamson Oil Co., Inc. (employee of owner) or (owner or operator)  
of the above-described well, being first duly sworn on oath, says: That I have knowledge of  
the facts, statements, and matters herein contained and the log of the above-described well  
as filed and that the same are true and correct. So help me God.

(Signature) Wilson Rains

435 Page Court, 220 W. Douglas, Wichita, Kans.  
(Address) 67202

SUBSCRIBED AND SWORN TO before me this 9 day of January, 1978



Juanita M. Green  
Juanita M. Green Notary Public.

# DRILLER'S LOG

5-173-20175-0000

COMPANY: Rains & Williamson Oil Co., Inc.

SEC. 11 T. 28S R. 2W

LOC. SW NE SW

WELL NAME: Thome #1

COUNTY: Sedgwick

RIG NO. #3

TOTAL DEPTH 3598'

ELEVATION 1384 GL 1389 KB

COMMENCED: 12-13-77

COMPLETED: 12-22-77

CONTRACTOR: Rains & Williamson Oil Co., Inc.

## CASING RECORD:

SURFACE: 8 5/8" @ 483' w/300 sx. common, 3% cc., 2% gel.

PRODUCTION: D&A

## LOG

(Figures Indicate Bottom of Formations)

Shale	2865
Shale & Lime	3008
Shale	3060
Lime	3280
Shale & Lime	3360
Lime	3598
<u>ROTARY TOTAL DEPTH</u>	<u>3598</u>

RECEIVED  
STATE CORPORATION COMMISSION

JAN 12 1978

CONSERVATION DIVISION  
Wichita, Kansas

STATE OF Kansas)

COUNTY OF Sedgwick)

SS:

I, Wilson Rains, President of Rains & Williamson Oil Co., Inc.

upon oath state that the above and foregoing is a true and correct copy of the log of the

Thome #1 well.

*Wilson Rains*

Wilson Rains

Subscribed and sworn to before me this 9 day of January, 1978.

Appointment Expires:

10-4-79

*Juanita M. Green*  
Juanita M. Green

