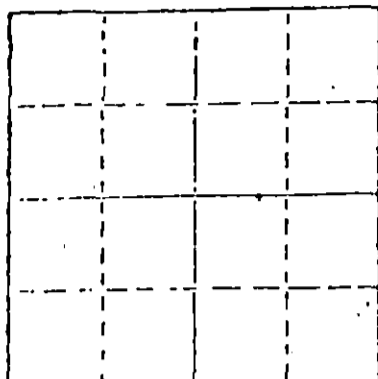


STATE OF KANSAS  
STATE CORPORATION COMMISSION15-173-20396-0000  
WELL PLUGGING RECORDGive All Information Completely  
Make Required Affidavit  
Mail or Deliver Report to  
Conservation Division  
State Corporation Comm.  
245 North Water  
Wichita, KS 67202Locate well correctly on above  
Section PlotSedgwick County. Sec. 1 Twp. 28S Rge. 2W E/W  
Location as "NE/CNW/SW" or footage from lines  
SW/4 NW SW SW  
Lease Owner Chief Drilling Co., Inc.  
Lease Name Tharp Well No. 1  
Office Address 905 Century Plaza, Wichita, Kans. 67202  
Character of Well (Completed as Oil, Gas or Dry Hole)  
dryDate Well completed 6-29-81 19  
Application for plugging filed 6-29-81 19  
Application for plugging approved 6-29-81 19  
Plugging commenced 6-29-81 19  
Plugging completed 6-29-81 19  
Reason for abandonment of well or producing formation  
dryIf a producing well is abandoned, date of last production  
19Was permission obtained from the Conservation Division or  
its agents before plugging was commenced? yesName of Conservation Agent who supervised plugging of this well Don Thompson  
Producing formation Depth to top Bottom Total Depth of Well 3555  
Show depth and thickness of all water, oil and gas formations.

## OIL, GAS OR WATER RECORDS

## CASING RECORD

FORMATION	CONTENT	FROM	TO	SIZE	PUT IN	PULLED OUT

Describe in detail the manner in which the well was plugged, indicating where the mud fluid  
was placed and the method or methods used in introducing it into the hold. If cement or other  
plugs were used, state the character of same and depth placed, from feet to  
feet for each plug set.Fluid to 445' Plug, 30 sks cement  
Fluid to 50' Plug, 15 sks cement  
5 sks cement in rat hole

(If additional description is necessary, use BACK of this sheet)

Name of Plugging Contractor Triangle Drilling & Exploration Co., Inc.  
2200 W..6th, El Dorado, Kansas 67042STATE OF Kansas COUNTY OF Butler, ss.  
Galen Navrat (employee of owner) or (owner or operator)  
of the above-described well, being first duly sworn on oath, says: That I have knowledge of  
the facts, statements, and matters herein contained and the log of the above-described well  
as filed and that the same are true and correct. So help me God.

(Signature)

Galen Navrat  
2200 W..6th, El Dorado, Kansas

SUBSCRIBED AND SWORN TO before me this 1st day of July, 19 81

My commission expires

VIOLET I. CROWE  
NOTARY PUBLIC  
STATE OF KANSAS  
MY APPT. EXP. 2-23-85

Violet I. Crowe Notary Public.

## WELL LOG

15-173-26396-0000

Operator Chief Drilling Co., Inc.  
 Comm \_\_\_\_\_ Comp \_\_\_\_\_  
 Shot \_\_\_\_\_ Qts. From \_\_\_\_\_ ft. To \_\_\_\_\_ ft.  
 Acidized \_\_\_\_\_ Gal. \_\_\_\_\_  
 Prod. Formation \_\_\_\_\_  
 Initial Prod. \_\_\_\_\_  
 Elevation \_\_\_\_\_

Lease Tharp Well No. 1  
 Loc NW SW SW Sec 1 Twp 28S Rge 2W  
 County Sedgwick State Kansas  
 Contractor Triangle Drlg & Expl Co., Inc.

## Casing Record

Size	Ft.	Pulled	Remarks
8 5/8	439	300 sks	cement

## FIGURES INDICATE BOTTOM OF FORMATION

0	-----	439	Surface
439	-----	765	Shale & Lime Stks
765	-----	865	Lime & Shale
865	-----	1245	Lime & Shale
1245	-----	1706	Lime & Shale
1706	-----	1790	Lime & Shale
1790	-----	2047	Lime & Shale
2047	-----	2295	Lime & Shale
2295	-----	2550	Lime & Shale
2550	-----	2810	Lime & Shale
2810	-----	3008	Lime & Shale
3008	-----	3080	K.C. Lime
3080	-----	3085	Shale
3085	-----	3145	Lime & Shale
3145	-----	3486	Shale
3486	-----	3555	Mississippi RTD

RECEIVED  
 STATE CORPORATION COMMISSION  
 CONSERVATION DIVISION  
 WICHITA, KANSAS  
 JUL 10 1981