


15-119-20522-00-00

STATE OF KANSAS  
STATE CORPORATION COMMISSION

WELL PLUGGING RECORD

Give All Information Completely  
Make Required Affidavit  
Mail or Deliver Report to  
Conservation Division  
State Corporation Comm.  
245 North Water  
Wichita, KS 67202

Meade County. Sec. 4 Twp. 33 Rge. 28W E/W  
Location as "NE/CNW 1/4 SW 1/4" or footage from lines 1200'S  
and 1550' west of NE/corner  
Lease Owner Southwest Gas Storage Co.  
Lease Name McNaghten Well No. 3-4  
Office Address Nye Rt. Box 62A Meade, Ks. 67684  
Character of Well (Completed as Oil, Gas or Dry Hole) \_\_\_\_\_

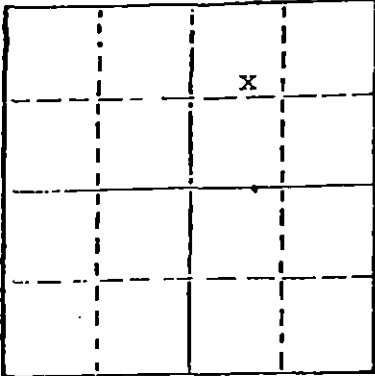

Locate well correctly on above  
Section Plat

Sink hole  
Date Well completed \_\_\_\_\_ 19\_\_\_\_  
Application for plugging filed Verbal 8-24-81 19\_\_\_\_  
Application for plugging approved Verbal 9-9-81 19\_\_\_\_  
Plugging commenced 9-15-81 19\_\_\_\_  
Plugging completed 9-16-81 19\_\_\_\_  
Reason for abandonment of well or producing formation  
Sink hole developed while drilling at 1424'  
If a producing well is abandoned, date of last production  
\_\_\_\_\_ 19\_\_\_\_

Was permission obtained from the Conservation Division or  
its agents before plugging was commenced? yes

Name of Conservation Agent who supervised plugging of this well Clarence Thomas  
Producing formation N/A Depth to top \_\_\_\_\_ Bottom \_\_\_\_\_ Total Depth of Well 1424'  
Show depth and thickness of all water, oil and gas formations.

OIL, GAS OR WATER RECORDS

CASING RECORD

FORMATION	CONTENT	FROM	TO	SIZE	PUT IN	PULLED OUT
Red bed at 350'	conductor	.65'	0	20"	65	5'
	8' Drill collar	1424	1361.50	8"	62.50	None
	Drill collar	1361.50	910.58	6 1/4"	450.92	None
	Drill pipe	910.58	0	4 1/2"	910.58	170.98
	Tubing	401'	0	2 3/8"	401.	5'

Describe in detail the manner in which the well was plugged, indicating where the mud fluid was placed and the method or methods used in introducing it into the hold. If cement or other plugs were used, state the character of same and depth placed, from 401' feet to 0 feet for each plug set. Washed to 401' with 2 3/8 tubing and cemented with 1000 SX with halliburton common cut off 20" conductor and 2 3/8 tub. five feet below ground level welded plate on 20" conductor.

RECEIVED  
STATE CORPORATION COMMISSION

NOV - 9 1981

CONSERVATION DIVISION

(If additional description is necessary, use BACK of this sheet)

Name of Plugging Contractor Patrick well ser. and Halliburton Co.

STATE OF Kanas COUNTY OF Meade, ss.  
D. R. Carlile (employee of owner) or (owner or operator)  
of the above-described well, being first duly sworn on oath, says: That I have knowledge of the facts, statements, and matters herein contained and the log of the above-described well as filed and that the same are true and correct. So help me God.

(Signature) [Signature]

(Address)

SUBSCRIBED AND SWORN TO before me this 6th day of November, 1981

Kathleen S. Dodson  
Notary Public.

My commission expires August 17, 1982

