

15-191-10183-0009

STATE OF KANSAS  
STATE CORPORATION COMMISSION


Give All Information Completely  
Make Required Affidavit  
Mail or Deliver Report to:  
Conservation Division  
State Corporation Commission  
212 North Market, Insurance Bldg.  
Wichita, Kansas

WELL PLUGGING RECORD

Sumner County. Sec. 5 Twp. 30 Rge. 2 (W)

Location as "NE/CNW/SW" or footage from lines SW-SW-NE  
Lease Owner Dunne-Gardner Drlg., Co., Inc.  
Lease Name Webb Well No. 1  
Office Address 300 Schwieter Bldg., Wichita 2, Kans.  
Character of Well (completed as Oil, Gas or Dry Hole) oil  
Date well completed Oct. 16 1958  
Application for plugging filed Jan. 13 1960  
Application for plugging approved Jan 13 1960  
Plugging commenced Jan. 14, 9:00 A. M. 1960  
Plugging completed Jan. 24 5:00 P. M. 1960  
Reason for abandonment of well or producing formation stop producing

NORTH

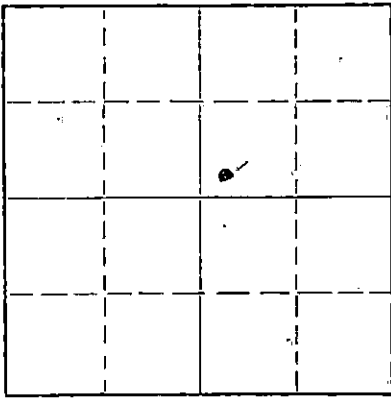

Locate well correctly on above  
Section Plat

If a producing well is abandoned, date of last production \_\_\_\_\_ 19\_\_\_\_  
Was permission obtained from the Conservation Division or its agents before plugging was commenced? yes

Name of Conservation Agent who supervised plugging of this well Lee Guthrie  
Producing formation Kansas City lime Depth to top 3145 Bottom 3179 Total Depth of Well 3220 Feet  
Show depth and thickness of all water, oil and gas formations.

OIL, GAS OR WATER RECORDS

CASING RECORD

FORMATION	CONTENT	FROM	TO	SIZE	PUT IN.	PULLED OUT
				8 5/8	211'	circulated
				5 1/2	3219	2642.83

Describe in detail the manner in which the well was plugged, indicating where the mud fluid was placed and the method or methods used in introducing it into the hole. If cement or other plugs were used, state the character of same and depth placed, from \_\_\_\_\_ feet to \_\_\_\_\_ feet for each plug set.

Filled hole with gravel to 3135'  
Dumped 5 sacks cement with bailer  
Set 20' rock bridge at 200' and dumped 15 sacks cement  
Mud to 35', set 5' rock bridge and dumped 10 sacks cement  
Filled to top, welded cap on surface.

RECEIVED  
STATE CORPORATION COMMISSION  
FEB 1 1960  
CONSERVATION DIVISION  
Wichita, Kansas

(If additional description is necessary, use BACK of this sheet)  
Name of Plugging Contractor Kent Well Servicing Company, Inc.  
Address Drawer 470, El Dorado, Kansas

STATE OF Kansas, COUNTY OF Butler, ss.  
\_\_\_\_\_  
(employee of owner) or (owner or operator) of the above-described well, being first duly sworn on oath, says: That I have knowledge of the facts, statements, and matters herein contained and the log of the above-described well as filed and that the same are true and correct. So help me God.

(Signature) C. D. Payne  
(Address) \_\_\_\_\_

SUBSCRIBED AND SWORN TO before me this 29th day of January, 1960

Ethelene E. Phillips  
Notary Public.

My commission expires June 18, 1963

DRILLING LOG

M

Company: Bedell-Catt Drilling Company  
701 Petroleum Building  
Wichita 2, Kansas

Lease: Webb

Well: #1

Location: SW SW NE of Section 5, Township 30, Range 2 West,  
Sumner County, Kansas

Contractor: Bedell-Catt Drilling Company  
701 Petroleum Building  
Wichita 2, Kansas

Date Comm: October 7, 1958

Date Comp: October 16, 1958

T. D.: 3220'

Production:

Casing: 8-5/8" to 211'/210 sacks cement  
4 sacks CC  
5-1/2" to 3219'

REC'D  
STATE CORPORATION  
APR 1 1960  
CONSERVATION DIVISION  
Wichita, Kansas

Figures Indicate the Bottom of Formation

0-211	Surface Hole
670	Shale & Shells
2703	Shale & Lime
2790	Sand
2836	Stalwaker Sand
3015	Shale & Lime
3220	Kansas City Lime
3220	T. D.

I certify the above to be true and correct to the best of my knowledge and belief.

BEDELL-CATT DRILLING COMPANY

By Corb S. Bedell  
Corb S. Bedell

Subscribed and sworn before me this 20th day of October, 1958.

Paul A. Seymour, Jr.  
Paul A. Seymour, Jr.  
Notary Public

My Commission Expires:

July 13, 1959