

RP


STATE OF KANSAS
STATE CORPORATION COMMISSION

Form CP-4

Give All Information Completely
Make Required Affidavit
Mail or Deliver Report to:
Conservation Division
State Corporation Commission
211 No. Broadway
Wichita, Kansas

WELL PLUGGING RECORD

NORTH

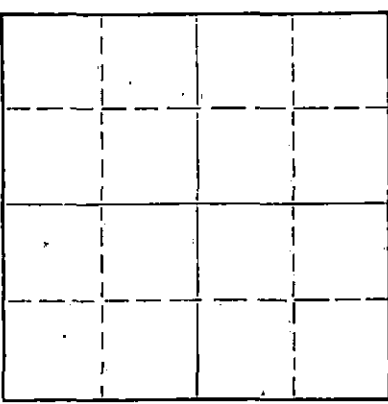

Locate well correctly on above Section Plat

Sumner County, Sec. 4 Twp. 30 Rge. 2 (E) W. (W)
Location as "NE/CNW/SW" or footage from lines SW NW SW
Lease Owner White & Ellis Drilling, Inc. et al
Lease Name Henry #1 Well No. 1
Office Address Box 448, El Dorado, Kansas 67042
Character of Well (completed as Oil, Gas or Dry Hole) Dry hole
Date well completed 9/7/ 19 65
Application for plugging filed 9/7/ 19 65
Application for plugging approved 9/7/ 19 65
Plugging commenced 9/7/ 19 65
Plugging completed 9/7/ 19 65
Reason for abandonment of well or producing formation Dry hole

If a producing well is abandoned, date of last production 19
Was permission obtained from the Conservation Division or its agents before plugging was commenced? Yes

Name of Conservation Agent who supervised plugging of this well Howard Hess
Producing formation _____ Depth to top _____ Bottom _____ Total Depth of Well 3262 Feet
Show depth and thickness of all water, oil and gas formations.

OIL, GAS OR WATER RECORDS

CASING RECORD

FORMATION	CONTENT	FROM	TO	SIZE	PUT IN	PULLED OUT
				8-5/8	211	

Describe in detail the manner in which the well was plugged, indicating where the mud fluid was placed and the method or methods used in introducing it into the hole. If cement or other plugs were used, state the character of same and depth placed, from _____ feet to _____ feet for each plug set.

Hole filled with heavy rotary mud to 225 ft. Bridge at 225 with hulls and 20 sacks cement. Hole filled with mud to 35 ft. Bridge at 35 feet with hulls and 8 sacks cement. Rat hole capped with 2 sacks cement.

RECEIVED
STATE CORPORATION COMMISSION
APR 22 1966
CONSERVATION DIVISION
Wichita, Kansas

(If additional description is necessary, use BACK of this sheet)
Name of Plugging Contractor White & Ellis Drilling, Inc. License #209
Address Box 448, El Dorado, Kansas 67042

STATE OF KANSAS COUNTY OF BUTLER ss.
Ernest Sifford, Employee of Contractor _____ of the above-described well, being first duly sworn on oath, says: That I have knowledge of the facts, statements, and matters herein contained and the log of the above-described well as filed and that the same are true and correct. So help me God.

(Signature) Ernest Sifford
Box 448, El Dorado, Kansas 67042
(Address)

SUBSCRIBED AND SWORN TO before me this 7th day of September, 19 65

My commission expires September 26, 1968 L. B. Auer Notary Public.

J White & Ellis

4-30-2W

CASING RECORD

8 5/8 211' Cemented w/ 150 sacks
T. D. 3262'

Location: SW NW SW
Section: 4-30-2W
Summer County, Kansas
Farm: Henry #1
Well Owner: White & Ellis et al
Contractor: White & Ellis Drilling, Inc.
Commenced: 8/31/65
Completed: 9/7/65

Kelly Bushing Measurement 5' above ground level.

<u>FORMATION</u>	<u>DEPTH</u>
Sandy Soil	0-30
Shale & Shells	211
Shale	470
Shale & Lime Streaks	565
Shale & Lime	2750
Sand & Sandy shale	3058
Lime	3262

TOPS

Kansas City 3058

RECEIVED
STATE CORPORATION COMMISSION

APR 22 1966

CONSERVATION DIVISION
Wichita, Kansas

Drv Hole. Plugged & Abandoned