


15-119-00112-0000

WELL PLUGGING RECORD

Give All Information Completely
Make Required Affidavit
Mail or Deliver Report to:
Conservation Division
State Corporation Commission
212 North Market, Insurance Bldg.
Wichita, Kansas

Meade County, Sec. 35 Twp. 33S Rge. 27 (E) (W)

Location as "NE/CNW4SW4" or footage from lines 1250' from south and west lines
Lease Owner The Shamrock Oil and Gas Corporation
Lease Name Elias D. Friesen et al Well No. 1
Office Address Box 631, Amarillo, Texas
Character of Well (completed as Oil, Gas or Dry Hole) Dry Hole
Date well completed 7-6 19 60
Application for plugging filed 7-7 19 60
Application for plugging approved 7-7 19 60
Plugging commenced 7-8 19 60
Plugging completed 7-8 19 60
Reason for abandonment of well or producing formation Dry

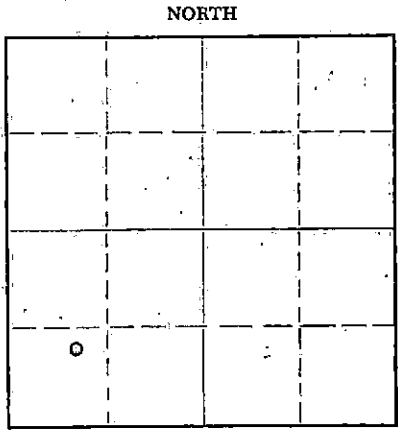

Locate well correctly on above Section Plat

If a producing well is abandoned, date of last production - 19
Was permission obtained from the Conservation Division or its agents before plugging was commenced? Yes

Name of Conservation Agent who supervised plugging of this well Bill Lackamp, Jr., Stafford, Kansas
Producing formation None Depth to top - Bottom - Total Depth of Well 6,060 Feet
Show depth and thickness of all water, oil and gas formations.

OIL, GAS OR WATER RECORDS

CASING RECORD

FORMATION	CONTENT	FROM.	TO	SIZE	PUT IN	PULLED OUT
Surface & sand	pos. water	0	223	8 5/8"	1,550	-0-

Describe in detail the manner in which the well was plugged, indicating where the mud fluid was placed and the method or methods used in introducing it into the hole. If cement or other plugs were used, state the character of same and depth placed, from _____ feet to _____ feet for each plug set.
Filled hole with heavy mud to 1,500'. Pushed 8 5/8" OD plug to 1,500', and spotted 25 sacks cement. Filled hole with mud to 600' and pushed 8 5/8" Plug to 600'. Spotted 1/2 sack hulls and 25 sacks cement on plug. Filled hole to 40' with mud and pushed 8 5/8" plug to 40'. Spotted 10 sacks cement to base of cellar.

RECEIVED
STATE CORPORATION COMMISSION
JUL 13 1960
CONSERVATION DIVISION
Wichita, Kansas

(If additional description is necessary, use BACK of this sheet)
Name of Plugging Contractor Halliburton Oil Well Cementing Co.
Address Liberal, Kansas

STATE OF Texas COUNTY OF Potter, ss.
T. S. Clopton (employee of owner) or (owner) of the above-described well, being first duly sworn on oath, says: That I have knowledge of the facts, statements, and matters herein contained and the log of the above-described well as filed and that the same are true and correct. So help me God.

(Signature) T. S. Clopton
Box 631, Amarillo, Texas (Address)

SUBSCRIBED AND SWORN TO before me this 12th day of July, 19 60
My commission expires 6-1-61
Pauline Powell
Notary Public
Potter County, Texas
Notary Public.

ELIAS D. FRIESEN ET AL NO. 1
 Section 35, Township 33 South, Range 27 West,
 Meade County, Kansas

0'	-	223'	Surface & sand
223'	-	650'	Red bed & sand
650'	-	1,016'	Sand, red bed & shale
1,016'	-	1,400'	Red bed
1,400'	-	1,478'	Lime & shale
1,478'	-	1,550'	Red bed & shale
1,550'	-	1,905'	Shale, shells & sand
1,905'	-	2,298'	Shale, lime & shells
2,298'	-	3,010'	Shale & lime
3,010'	-	3,080'	Lime
3,080'	-	3,300'	Lime & chalk
3,300'	-	3,410'	Lime
3,410'	-	4,365'	Lime & shale
4,365'	-	4,485'	Shale
4,485'	-	5,037'	Lime & shale
5,037'	-	5,306'	Lime
5,306'	-	5,427'	Lime & shale
5,427'	-	5,824'	Lime
5,824'	-	5,894'	Sand
5,894'	-	6,060'	Lime

RECEIVED
 STATE CORPORATION COMMISSION
 JUL 13 1960
 CONSERVATION DIVISION
 Topeka, Kansas