

STATE OF KANSAS  
STATE CORPORATION COMMISSION

Form CP-4

Give All Information Completely  
Make Required Affidavit  
Mail or Deliver Report to:  
Conservation Division  
State Corporation Commission  
212 No. Market  
Wichita, Kansas 67202

WELL PLUGGING RECORD

Meade County, Sec. 32 Twp. 33-S Rge. (E) 27 (W)

Location as "NE/CNWSW" or footage from lines NE NE SW

Lease Owner Saxon Oil Company

Lease Name C. J. Dirks Well No. 1

Office Address 600 First National Bank Bldg., Abilene, Texas 79601

Character of Well (completed as Oil, Gas or Dry Hole) Dry Hole

Date well completed 12/18 1971

Application for plugging filed 1/12 1972

Application for plugging approved 19


Plugging commenced 12/18 1971

Plugging completed 12/18 1971

Reason for abandonment of well or producing formation Dry Hole

If a producing well is abandoned, date of last production - - 19

Was permission obtained from the Conservation Division or its agents before plugging was commenced? Yes

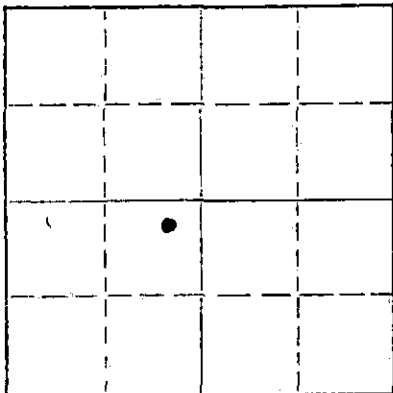

Locate well correctly on above Section Plat

Name of Conservation Agent who supervised plugging of this well

Producing formation None Depth to top - - Bottom - - Total Depth of Well 6042 Feet

Show depth and thickness of all water, oil and gas formations.

OIL, GAS OR WATER RECORDS

CASING RECORD

FORMATION	CONTENT	FROM	TO	SIZE	PUT IN	PULLED OUT
Chester Lime	Gas	5880	5906	8 5/8"	1392	0

Describe in detail the manner in which the well was plugged, indicating where the mud fluid was placed and the method or methods used in introducing it into the hole. If cement or other plugs were used, state the character of same and depth placed, from feet to feet for each plug set.

Hole full of 8.8# mud  
35 sack cement plug at 1000' to 900'  
15 sack cement plug 0' to 45'

RECEIVED  
STATE CORPORATION COMMISSION  
JAN 14 1972  
CONSERVATION DIVISION  
Wichita, Kansas

(If additional description is necessary, use BACK of this sheet)

Name of Plugging Contractor Lohman-Johnson Drilling Co.

Address Oklahoma City, Oklahoma

STATE OF Texas, COUNTY OF Taylor, ss.

John R. Stearns

(employee of owner) or (owner or operator) of the above-described well, being first duly sworn on oath, says: That I have knowledge of the facts, statements, and matters herein contained and the log of the above-described well as filed and that the same are true and correct. So help me God.

(Signature) John R. Stearns

600 First National Bank Bldg., Abilene, Tex.

(Address)

SUBSCRIBED AND SWORN to before me this 12 day of January, 1972

My commission expires 6/01/73

Gayle Wimberly Notary Public.