

STATE OF KANSAS
STATE CORPORATION COMMISSION


CORRECTED COPY

WELL PLUGGING RECORD

Give All Information Completely
Make Required Affidavit
Mail or Deliver Report to:
Conservation Division
State Corporation Commission
211 No. Broadway
Wichita, Kansas

Kingman County. Sec. 5 Twp. 30S Rge. (E) 7 (W)
Location as "NE/CNW/SW" or footage from lines CN/2 NE/4 NE/4
Lease Owner Pickrell Drilling Company
Lease Name Young B Well No. 1
Office Address 705 Fourth National Bank Building - Wichita 2, Kansas
Character of Well (completed as Oil, Gas or Dry Hole) Dry hole
Date well completed March 27 1957
Application for plugging filed March 27 1957
Application for plugging approved March 27 1957
Plugging commenced March 27 1957
Plugging completed March 27 1957
Reason for abandonment of well or producing formation D & A

NORTH

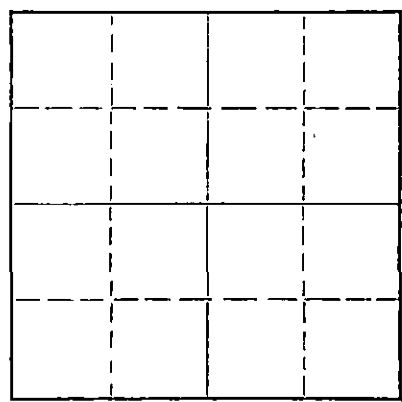

Locate well correctly on above
Section Plat

If a producing well is abandoned, date of last production _____ 19____
Was permission obtained from the Conservation Division or its agents before plugging was commenced? Yes

Name of Conservation Agent who supervised plugging of this well M. A. Rives
Producing formation _____ Depth to top _____ Bottom _____ Total Depth of Well 4230 Feet
Show depth and thickness of all water, oil and gas formations.

OIL, GAS OR WATER RECORDS

CASING RECORD

FORMATION	CONTENT	FROM	TO	SIZE	PUT IN	PULLED OUT
				8 5/8"	160'	None

Describe in detail the manner in which the well was plugged, indicating where the mud fluid was placed and the method or methods used in introducing it into the hole. If cement or other plugs were used, state the character of same and depth placed, from _____ feet to _____ feet for each plug set.

Filled with heavy mud to 200'; bridge hole and cemented with 20 sacks cement. Then heavy mud to 20' below cellar, bridge hole and cement with 10 sacks to bottom of cellar.

(If additional description is necessary, use BACK of this sheet)

Name of Plugging Contractor Pickrell Drilling Company
Address 705 Fourth National Bank Building, Wichita 2, Kansas

STATE OF Kansas, COUNTY OF Sedgwick, ss.
C. W. Sebitts (owner or operator) of the above-described well, being first duly sworn on oath, says: That I have knowledge of the facts, statements, and matters herein contained and the log of the above-described well as filed and that the same are true and correct. So help me God.

(Signature) [Signature]
705 Fourth National Bank Building, Wichita 2, Ks.
(Address)

SUBSCRIBED AND SWORN TO before me this 14th day of May, 1957

My commission expires July 30, 1958

[Signature]
Dorothy L. Hester
Notary Public.
STATE CORPORATION COMMISSION

PLUGGING
FILE SEC. 5 T. 30 R. 7W
BOOK PAGE 3 LINE 16

MAY 15 1957
CONSERVATION DIVISION
Wichita, Kansas

ROTARY DRILLING LOG

COMPANY: Pickrell Drilling Company
Wichita, Kansas

Rotary Drilling Commenced 3/11/57

LOCATION: CN/2 NE NE Sec. 5-30S-7W, Kingman County, Kansas

Rotary Drilling Completed 3/27/57

Young B-1

CONTRACTOR: PICKRELL DRILLING COMPANY
Wichita, Kansas

CASING RECORD: 160' (4 jts.) 8 5/8" 22.7# Armco Spiralweld Casing set at 160' with 80 sacks cement circulated.

Filled with heavy mud to 200', bridge hole and cemented with 20 sx. cement. Then heavy mud to 20' below cellar, bridge hole and cement with 10 sx. to bottom of cellar.

LOG

(Figures indicate bottom of formation—measurements from top of rotary bushing.)

Red Rock	160	Circ. for samples at 3813
Red Rock & Shale	280	4145
Shale & Shells	700	4165
Salt, Shale & Shells	1050	4210
Shale & Lime	1520	4230
Lime	1925	
Shale & Lime	2625	
Lime	2765	
Lime & Shale	2845	
Lime	3051	
Lime & Shale	3113	
Lime, Sand, & Shale	3234	
Shale & Lime	3372	
Lime	3553	
Lime & Shale	3602	
Lime	3873	
Lime & Shale	3940	
Lime	3990	
Lime & Shale	4132	
Mississippi	4230 T.D.	

S.L.M. at 1500 - O.K.
3000 - O.K.
4000 - O.K.

Slope Test at 1500 - 0° off
3000 - 0° off
4000 - 0° off

PLUGGING
FILE SEC 5 T. 30 R. 7W
BOOK PAGE 3 LINE 16

RECEIVED
STATE CORPORATION COMMISSION
APR 5 - 1957
CONSERVATION DIVISION
Wichita, Kansas

The undersigned, C. W. Sebitts, Attorney-in-Fact, for PICKRELL DRILLING COMPANY, hereby certifies in behalf of said Company, that the above is a true and correct log of the formation encountered in drilling the above well as reflected by the Daily Drilling Reports.

PICKRELL DRILLING COMPANY
By [Signature]
Attorney-in-Fact

STATE OF KANSAS }
COUNTY OF SEDGWICK } ss.:

On this 3rd day of April, 1957, before me the undersigned, a Notary Public, in and for the County and State aforesaid, personally appeared C. W. Sebitts to me known to be the identical person who subscribed the name of PICKRELL DRILLING COMPANY to the foregoing instrument as its Attorney-in-Fact and acknowledged to me that he executed the same as his free and voluntary act and deed; and as the free and voluntary act and deed of such company, for the uses and purposes therein set forth.

Given under my hand and seal of office the day and year last above written.

My commission expires: July 30, 1958

[Signature]
Notary Public