


RECEIVED
STATE CORPORATION COMMISSION

WELL PLUGGING RECORD

JUL 19 1963

Give All Information Completely
Make Required Affidavit
Mail or Deliver Report to:
Conservation Division
State Corporation Commission
212 North Market, Insurance Bldg.
Wichita, Kansas

KINGMAN County Sec. 5 Twp. 30S Rge. (E) 7 (W)
Location as "NE/CNW/SW" or footage from lines C W/2 SW/4 SW/4
Lease Owner GABBERT-JONES INC.
Lease Name RENDER
Office Address 514 ORPHEUM BLDG., WICHITA 2, KANSAS
Character of Well (completed as Oil, Gas or Dry Hole) DRY HOLE
Date well completed 7/13 19 63
Application for plugging filed Phone 7/13 19 63
Application for plugging approved Phone 7/13 19 63
Plugging commenced 7/13 19 63
Plugging completed 7/14 19 63
Reason for abandonment of well or producing formation DRY HOLE

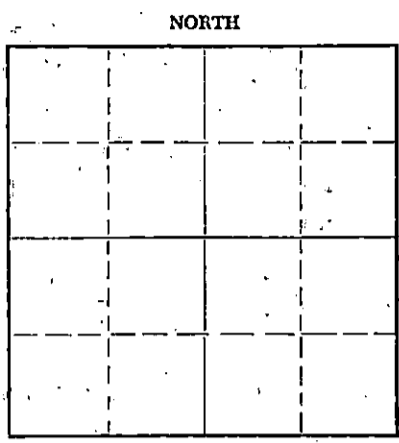

Locate well correctly on above Section Flat

If a producing well is abandoned, date of last production: 19
Was permission obtained from the Conservation Division or its agents before plugging was commenced? YES

Name of Conservation Agent who supervised plugging of this well HERMAN E. JUSTICE ARCHIE ELVING
Producing formation: Depth to top Bottom Total Depth of Well 4201 Feet
Show depth and thickness of all water, oil and gas formations.

OIL, GAS OR WATER RECORDS

CASING RECORD

FORMATION	CONTENT	FROM	TO	SIZE	PUT IN	PULLED OUT
				8-5/8"	254'	NONE

Describe in detail the manner in which the well was plugged, indicating where the mud fluid was placed and the method or methods used in introducing it into the hole. If cement or other plugs were used, state the character of same and depth placed, from feet to feet for each plug set.

SET FIRST PLUG 240'. CEMENTED W/ 1/4 SACK HULLS, 20 SACKS CEMENT. FILLED W/ HEAVY MUD TO 40'.
SET SECOND PLUG 40' W/ 1/4 SACK HULLS, 10 SACKS CEMENT.
PLUGGED RAT HOLE W/ 2 SACKS CEMENT.

(If additional description is necessary, use BACK of this sheet)

Name of Plugging Contractor GABBERT-JONES INC.
Address 514 ORPHEUM BLDG., WICHITA 2, KANSAS

STATE OF KANSAS, COUNTY OF SEDGWICK, ss.
EMMET E. HALL (employee of owner) or (owner or operator) of the above-described well, being first duly sworn on oath, says: That I have knowledge of the facts, statements, and matters herein contained and the log of the above-described well as filed and that the same are true and correct. So help me God.

(Signature) *Emmet E. Hall*

514 ORPHEUM BLDG., WICHITA, KANSAS (Address)

SUBSCRIBED AND SWORN TO before me this 18TH day of JULY, 19 63

Vira A. McKenzie
VIRA A. MCKENZIE Notary Public.

My commission expires OCTOBER 2, 1963

RECEIVED
STATE CORPORATION COMMISSION

JUL 19 1963

CONSERVATION DIVISION
Wichita, Kansas

GABBERT-JONES INC.
WICHITA, KANSAS
DRILLERS WELL-LOG

RENDER #1
C. W/2 SW/4 SW/4 SECTION 5-30S-7W
KINGMAN COUNTY, KANSAS

COMMENCED: JULY 3, 1963
COMPLETED: JULY 13, 1963

OPERATOR - GABBERT-JONES INC.

DEPTH		FORMATION	REMARKS
FROM	TO		
0	75	RED BED	
75	254	RED BED & SHELLS	RAN 12 JOINTS 8-5/8" CASING, SET @ 254' W/ 200 SACKS CEMENT
254	550	RED BED, SHALE & SHELLS	
550	1125	SHALE & SHELLS	
1125	1140	ANHYDRITE	
1140	1480	LIME & SHALE	
1480	1730	LIME	
1730	3600	LIME & SHALE	
3600	3900	LIME	
3900	4015	SHALE & LIME	
4015	4100	LIME	
4100	4135	SHALE & LIME	
4135	4155	SHALE	
4155	4201	MISSISSIPPI	
4201	TD		DRY & ABANDONED

I, E. E. HALL, CERTIFY THIS IS A TRUE AND CORRECT COPY OF THE DRILLER'S LOG FOR THE WELL DRILLED IN C W/2 SW/4 SW/4 SECTION 5-30S-7W, KINGMAN COUNTY, KANSAS, TO THE BEST OF MY KNOWLEDGE AND BELIEF.

E. E. Hall
E. E. HALL

STATE OF KANSAS)
) SS
COUNTY OF SEDGWICK)

BEFORE ME, THE UNDERSIGNED, A NOTARY PUBLIC WITHIN AND FOR SAID COUNTY AND STATE, ON THIS 16TH DAY OF JULY, 1963, PERSONALLY APPEARED E. E. HALL TO ME PERSONALLY KNOWN TO BE THE IDENTICAL PERSON WHO EXECUTED THE WITHIN AND FOREGOING INSTRUMENT AND ACKNOWLEDGED TO ME THAT HE EXECUTED THE SAME AS HIS FREE AND VOLUNTARY ACT AND DEED FOR THE USES AND PURPOSES THEREIN SET FORTH.

IN WITNESS WHEREOF, I HAVE HEREUNTO SET MY HAND AND OFFICIAL SEAL THE DAY AND YEAR LAST ABOVE WRITTEN.

Vera A. McKenzie
VERA A. MCKENZIE, NOTARY PUBLIC

MY COMMISSION EXPIRES OCTOBER 2, 1963