


STATE OF KANSAS  
STATE CORPORATION COMMISSION  
CONSERVATION DIVISION  
P. O. BOX 17027  
WICHITA, KANSAS 67217

WELL PLUGGING RECORD

Kingman County, Sec 4 Twp. 30S Rge. 7W (E) (W)  
Location as "NE/CNWSW" or footage from lines SE NE NW

Lease Owner Gear Petroleum Co.  
Lease Name Lecklider Well No. 1  
Office Address 1320 Vickers KSB&T Bldg., Wichita, Ks. 67202  
Character of Well (completed as Oil, Gas or Dry Hole) Dry Hole  
Date well completed March 25, 1976 19  
Application for plugging filed March 24, 1976 19  
Application for plugging approved March 24, 1976 19  
Plugging commenced March 25, 1976 19  
Plugging completed March 25, 1976 19  
Reason for abandonment of well or producing formation

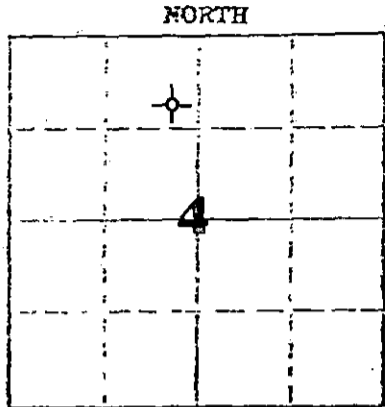

Locate well correctly on above Section Plat

If a producing well is abandoned, date of last production 19  
Was permission obtained from the Conservation Division or its agents before plugging was commenced? yes

Name of Conservation Agent who supervised plugging of this well G. R. Biberstein  
Producing formation Depth to top Bottom Total Depth of Well 4184 Feet  
Show depth and thickness of all water, oil and gas formations.

OIL, GAS OR WATER RECORDS CASING RECORD

FORMATION	CONTENT	FROM	TO	SIZE	PUSH IN	PULLED OUT
				8 5/8"	215.90'	-0-

Describe in detail the manner in which the well was plugged, indicating where the mud fluid was placed and the method or methods used in introducing it into the hole. If cement or other plugs were used, state the character of same and depth placed, from feet to feet to

Mud to 200' + 35 sx cmt  
Mud to 40' + 1/2 sx hulls, plug 10 sx cmt  
2 sx cmt in rathole  
RECEIVED  
APR 08 1976  
CONSERVATION DIVISION  
WICHITA, KANSAS

(If additional description is necessary, use BACK of this sheet)  
Name of Plugging Contractor Red Tiger Drilling Co.  
Address 1720 KSB&T Bldg., Wichita, Ks. 67202


STATE OF Kansas COUNTY OF Sedgwick  
Jean Stocks (employee of owner) or (partner of partner) of the above-described

well, being first duly sworn on oath, says: That I have knowledge of the facts, statements, and matters herein contained and the log of the above-described well as filed and that the same are true and correct. So help me God.

(Signature) Jean Stocks  
1720 KSB&T Bldg., Wichita, Ks. 67202  
(Address)

Subscribed and sworn to before me this 29th day of March, 1976

My commission expires  
D. Ann Drennan Notary Public

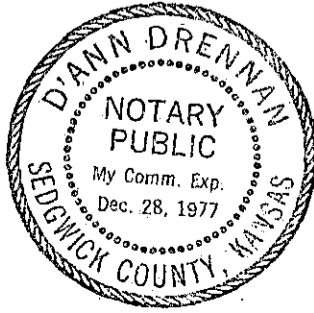

Drillers Log

No. 1 Lecklider

CASING RECORD:

COMPANY: Gear Petroleum Company

DESCRIPTION:

8 5/8" @ 222'  
w/225 sx cmt

CONTRACTOR: Red Tiger Drilling Company

SE NE NW  
Sec. 4-30S-7W  
Kingman County, Kansas

COMMENCED: March 17, 1976

COMPLETED: March 25, 1976

TOTAL DEPTH: 4184'

ELEVATION: 1474' GL

FORMATION	FROM	TO	REMARKS
Rock & Redbed	0	100	
Rock & Redbed	100	226	
Redbeds	226	330	
Shale	330	1060	
Lime & Shale	1060	1071	
Shale	1071	1100	
Lime & Shale	1100	1390	
Shale & Lime	1390	1600	
Lime & Shale	1600	1900	
Lime & Shale	1900	2140	
Lime & Shale	2140	2390	
Lime & Shale	2390	2581	
Lime	2587	2600	
Lime & Shale	2600	2795	
Lime	2795	3000	
Lime	3000	3190	
Lime	3190	3390	
Lime	3390	3510	
Lime	3510	3635	
Lime	3635	3760	
Lime	3760	3865	
Lime	3865	3945	
Lime	3945	4005	
Lime	4005	4070	
Lime	4070	4125	
Lime	4125	4158	
Lime	4158	4160	
Lime	4160	4184	
RTD		4184	

APR 02 1976

I certify that this is a true and correct copy of the above log to the best of my knowledge.

RED TIGER DRILLING COMPANY

*Jean Stocks*  
Jean Stocks

Subscribed & sworn to before me this 29th day of March, 1976.

*D Ann Drennan*  
Notary Public

