NOTE: Well was dry deep. Kaiser-Francis took operations over to run production casing shallow. APC has no working interest in shallow zones.

SIDE ONE

STATE CORPORATION COMMISSION OF KANSAS
OIL & GAS CONSERVATION DIVISION
WELL COMPLETION OR RECOMPLETION FORM
ACO-1 WELL HISTORY
DESCRIPTION OF WELL AND LEASE

5

API NO. 15- 175-21,067 ~00-00~

County: Seward

S/2 SE NW Sec. 19 Twp. 34S Rge. 31 __ East X West

2970 Ft North from Southeast Corner of Section
3300 Ft West from Southeast Corner of Section
(Note: Locate well in section plat below)

Lease Name: Heyen Trust "A" Well #: 1

Field Name: Kneeland

Producing Formation: NA

Elevation: Ground: 2725 KB: 2737

Operator: License # 4549
Name: Anadarko Petroleum Corporation
Address: P. O. Box 351
City/State/Zip: Liberal, Kansas 67905-0351

Purchaser: NA

Operator Contact Person: M. L Pease
Phone: (316) 624-6253

Contractor: License # 5842
Name: Gabbert-Jones, Inc.

Wellsite Geologist: NA
Phone:

Designate Type of Completion
X New Well __ Re-Entry __ Workover

__ Oil __ SWD __ Temp Abd
__ Gas __ Inj __ Delayed Comp.
X Dry __ Other (Core, Water Supply etc.)

If OWWO: old well info as follows:
Operator:
Well Name:
Comp. Date: Old Total Depth:

Section Plat

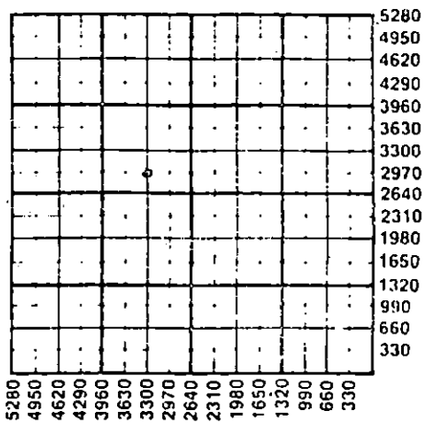


WELL HISTORY

Drilling Method:
X Mud Rotary __ Air Rotary __ Cable

| 12/20/88 | 1/7/89 | NA |
|---|---|---|
| Spud Date | Date Reached TD | Completion Date |

| 6500 | NA |
|---|---|
| Total Depth | PBTD |

Amount of Surface Pipe Set and Cemented at 1417 feet
Multiple Stage Cementing Collar Used? __ Yes X No
If yes, show depth set: feet
If alternate 2 completion, cement circulated from: feet depth to: w/ SX cmt
Cement Company Name: Dowell Schlumberger
Invoice #: 03-12-1360

WATER SUPPLY INFORMATION
Disposition of Produced Water: __ Disposal
Docket #: __ Repressuring

Questions on this portion of the ACO-1 call:
Water Resources Board (913) 296-3717
Source of Water:
Division of Water Resources Permit #:

__ Groundwater: Ft North from Southeast Corner
(Well): Ft West from Southeast Corner of
Sec Twp Rge __ East __ West

__ Surface Water: Ft North from Southeast Corner
(Stream, pond etc): Ft West from Southeast Corner
Sec Twp Rge __ East __ West

X Other (explain): Contractor provided water
(purchased from city, R.W.D. #)

A/r I

INSTRUCTIONS: This form shall be completed in triplicate and filed with the Kansas Corporation Commission, 200 Colorado Derby Building, Wichita, Kansas 67202, within 120 days of the spud date of any well. Rule 82-3-130, 82-3-107 and 82-3-106 apply.
Information on side two of this form will be held confidential for a period of 12 months if requested in writing and submitted with the form. See rule 82-3-107 for confidentiality in excess of 12 months.
One copy of all wireline logs and drillers time log shall be attached with this form. Submit CP-4 form with all plugged wells. Submit CP-111 form with all temporarily abandoned wells.

RECEIVED
STATE CORPORATION COMMISSION
MAR 15 1989
CONSERVATION DIVISION
Wichita, Kansas

All requirements of the statutes, rules and regulations promulgated to regulate the oil and gas industry have been fully complied with and the statements herein are complete and correct to the best of my knowledge.

Signature: M. L. Pease
Title: Division Production Manager Date: 3/14/89

Subscribed and sworn to before me this 15th day of March, 19 89.
Notary Public: Glenna S. Kelley
Date Commission Expires:

K.C.C. OFFICE USE ONLY
F ✓ Letter of Confidentiality Attached
C ✓ Wireline Log Received
C __ Drillers Timelog Received
Distribution
✓ KCC __ SWD/Rep __ NGPA
✓ KGS __ Plug __ Other (Specify)
3-15-89

Sec. 19 Twp. 34 Rge. 31 W

Form ACO-1 (5-86)