

STATE CORPORATION COMMISSION OF KANSAS  
OIL & GAS CONSERVATION DIVISION  
WELL COMPLETION OR RECOMPLETION FORM  
ACO-1 WELL HISTORY  
DESCRIPTION OF WELL AND LEASE

Operator: License # 4549  
Name: Anadarko Petroleum Corporation  
Address: P.O. Box 351  
City/State/Zip: Liberal, KS 67905-0351

Purchaser: Panhandle Eastern Pipe Line Co.  
(Transporter)

Operator Contact Person: M. L. Pease  
Phone: (316) 624-6253

Contractor: License # 5842  
Name: Gabbert-Jones, Inc.

Wellsite Geologist: NA  
Phone:

Designate Type of Completion  
 New Well  Re-Entry  Workover

Oil  SWD  Temp Abd  
 Gas  Inj  Delayed Comp  
 Dry  Other (Core, Water Supply etc.)

If OWWO: old well info as follows:  
Operator  
Well Name  
Comp. Date  
Old Total Depth

WELL HISTORY

Drilling Method:  
 Mud Rotary  Air Rotary  Cable

3-9-89 Spud Date  
3-12-89 Date Reached TD  
5-12-89 Completion Date  
2948 Total Depth  
2930 PBD

Amount of Surface Pipe Set and Cemented at 560 feet  
Multiple Stage Cementing Collar Used? Yes No  
If yes, show depth set feet  
If alternate 2 completion, cement circulated from feet depth to feet depth  
Cement Company Name: Dowell Schlumberger, Inc.  
Invoice # 03-12-1502

API NO. 15-189-21, 315-00-00

County: Stevens

NW NE NE Sec 6 34S 38 East  
West

4950 Ft North from Southeast Corner of Section  
1250 Ft West from Southeast Corner of Section  
(Note: Locate well in section plat below)


Lease Name: Bane "J" Well # 1H

Field Name: Hugoton

Producing Formation: Chase

Elevation: Ground 3223.8 KB NA

Section Plat

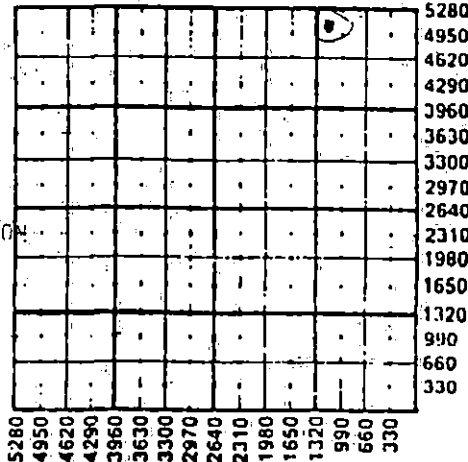

RECEIVED  
STATE CORPORATION COMMISSION  
CONSERVATION DIVISION  
Wichita, Kansas

WATER SUPPLY INFORMATION

Disposition of Produced Water: Disposal  
Docket # Repressuring

Questions on this portion of the ACO-1 call:  
Water Resources Board (913) 296-3717

Source of Water:  
Division of Water Resources Permit #

Groundwater: Ft North from Southeast Corner (Well)  
Ft West from Southeast Corner of Sec Twp Rge East West

Surface Water: Ft North from Southeast Corner (Stream, pond etc.)  
Ft West from Southeast Corner Sec Twp Rge East West

Other (explain) water provided by contractor (purchased from city, R.W.D. #)

INSTRUCTIONS: This form shall be completed in triplicate and filed with the Kansas Corporation Commission, 200 Colorado Derby Building, Wichita, Kansas 67202, within 120 days of the spud date of any well. Rule 82-3-130, 82-3-107 and 82-3-106 apply. Information on side two of this form will be held confidential for a period of 12 months if requested in writing and submitted with the form. See rule 82-3-107 for confidentiality in excess of 12 months. One copy of all wireline logs and drillers time log shall be attached with this form. Submit CP-4 form with all plugged wells. Submit CP-111 form with all temporarily abandoned wells.

All requirements of the statutes, rules and regulations promulgated to regulate the oil and gas industry have been fully complied with and the statements herein are complete and correct to the best of my knowledge.

Signature: David W. Kappler  
Title: Division Production Engineer Date: 8/2/89

Subscribed and sworn to before me this 2nd day of August 1989.  
Notary Public: Cheryl Steers

Date Commission Expires: CHERYL STEERS  
Notary Public - State of Kansas  
My Appt. Expires 6-1-93

K.C.C. OFFICE USE ONLY  
F Letter of Confidentiality Attached  
C Wireline Log Received  
C Drillers Timelog Received  
Distribution  
KCC SWD/Rep NGPA  
KGS Plug Other  
(Specify)