

This form shall be filed in duplicate with the Kansas Corporation Commission, 200 Colorado Derby Building, Wichita, Kansas 67202, within ten days after the completion of the well, regardless of how the well was completed.

Attach separate letter of request if the information is to be held confidential. If confidential, only file one copy. Information on side one will be of public record and side two will then be held confidential.

Circle one: Oil, Gas, Dry, SWD, (OWO), Injection. Type and complete ALL sections.

Applications must be filed for dual completion, commingling, SWD and injection, T.A.

Attach wireline logs (i.e. electrical log, sonic log, gamma ray neutron log, etc.). KCC # (316) 263-3238. (Rules 82-2-105 & 82-2-125)

OPERATOR Cities Service Company

API NO. 15-129-10.320 00-00

ADDRESS 3545 N.W. 58th Street

COUNTY Morton

Oklahoma City, Oklahoma

FIELD Wilburton

**CONTACT PERSON Larry Ervin

PROD. FORMATION

PHONE 405-949-4277

LEASE Salmon A

PURCHASER

WELL NO. 1

ADDRESS

WELL LOCATION SE SW

DRILLING Barbour Drilling Company

660 Ft. from South Line and

CONTRACTOR

1980 Ft. from West Line of

ADDRESS

the SW 1/4 SEC. 33 TWP. 34S RGE. 41W


Tulsa, Oklahoma

WELL PLAT

PLUGGING

CONTRACTOR

ADDRESS

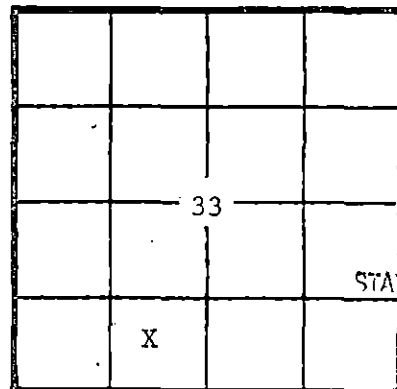

KCC KGS (Office Use)

TOTAL DEPTH 5340' PBD 5021'

SPUD DATE 12-10-60 DATE COMPLETED 3-14-61

ELEV: GR 3496' DF 3506' KB

DRILLED WITH (ROTARY) TOOLS

RECEIVED STATE CORPORATION COMMISSION

DEC 21 1981

Amount of surface pipe set and cemented 1518'

DV Tool Used? No

CONSERVATION DIVISION Wichita, Kansas

AFFIDAVIT

STATE OF Oklahoma, COUNTY OF Oklahoma SS, I,

W. A. Givens OF LAWFUL AGE, BEING FIRST DULY SWORN UPON HIS OATH,

DEPOSES THAT HE IS Production Region Manager (FOR CITIES) Cities Service Company

OPERATOR OF THE Salmon A #1 LEASE, AND IS DULY AUTHORIZED TO MAKE

THIS AFFIDAVIT FOR AND ON THE BEHALF OF SAID OPERATOR, THAT WELL NO. 1 ON

SAID LEASE HAS BEEN Re-Completed AS OF THE 27th DAY OF August, 19 80, AND THAT

ALL INFORMATION ENTERED HEREIN WITH RESPECT TO SAID WELL IS TRUE AND CORRECT.

FURTHER AFFIANT SAITH NOT.

(S) W.A. Givens W. A. Givens - Production Reg. Mgr. December, 19 81

SUBSCRIBED AND SWORN BEFORE ME THIS 17th DAY OF

MY COMMISSION EXPIRES: 6-10-84

Joyce S. Darter NOTARY PUBLIC Joyce S. Darter

**The person who can be reached by phone regarding any questions concerning this information. Within 45 days of completion, a witnessed initial test by the Commission is required if the well produces more than 25 BOPD or is located in a Basic Order Pool.

SIDE TWO

WELL LOG

SHOW GEOLOGICAL MARKERS, LOGS RUN, OR OTHER DESCRIPTIVE INFORMATION.

Show all important zones of porosity and contents thereof; cored intervals, and all drill-stem tests, including depth interval tested, cushion used, time tool open, flowing and shut-in pressures, and recoveries.

FORMATION DESCRIPTION, CONTENTS, ETC.	TOP	BOTTOM	NAME	DEPTH
See Original Kansas State Completion Forms				
Note: The Salmon A-1 Upper Morrow zone (4908- 4918) was squeezed 8-27-80 with 115 sacks of cement. The well was then recompleted 9-12-80 as the Wilburton Morrow Sand Unit #1701 in the Morrow zone (4971-4976). (See ACO-1 for Wilburton Morrow C Sand Unit #1701).				

Report of all strings set— surface, intermediate, production, etc. **CASING RECORD** (New) or ~~(XXXXX)~~

Purpose of string	Size hole drilled	Size casing set (in O.D.)	Weight lbs/ft.	Setting depth	Type cement	Sacks	Type and percent additives
Surface	12-1/4"	8-5/8"	24#	1518'	Pozmix	750	
Production	7-7/8"	5-1/2"	14#	5181'	Pozmix	300	

LINER RECORD

PERFORATION RECORD

Top, ft.	Bottom, ft.	Sacks cement	Shots per ft.	Size & type	Depth interval
			4	DPJS	4908-4918'

TUBING RECORD

Size	Setting depth	Packer set at

ACID, FRACTURE, SHOT, CEMENT SQUEEZE RECORD

Amount and kind of material used	Depth interval treated
Squeezed 115 sx cement into formation	4908 - 4918'

Date of first production	Producing method (flowing, pumping, gas lift, etc.)	Gravity

RATE OF PRODUCTION PER 24 HOURS	Oil	Gas	Water	Gas-oil ratio
	bbls.	MCF	%	bbls.
				CFPB

Disposition of gas (vented, used on lease or sold)	Perforations