


WELL PLUGGING RECORD

Give All Information Completely  
Make Required Affidavit  
Mail or Deliver Report to:  
Conservation Division  
State Corporation Commission  
211 No. Broadway  
Wichita, Kansas

Seward County, Sec. 10 Twp. 32 Rge. 33 (E) W (W)

Location as "NE/CNW/SW" or footage from lines ~~XXXXXX~~ C NW/4  
Lease Owner Pan American Petroleum Corporation  
Lease Name ~~XXXXXX~~ Sam G. Specht Well No. 1  
Office Address Ilysses, Kansas  
Character of Well (completed as Oil, Gas or Dry Hole) Oil (4-12-62 on Temp. Prod.)  
Date well completed as dry hole 6-13 19 62  
Application for plugging filed Confirming reprt will follow 19  
Application for plugging approved 7-5 19 62  
Plugging commenced 9-29-62 19  
Plugging completed 9-30-62 19  
Reason for abandonment of well or producing formation Depleted, production declined to zero.  
If a producing well is abandoned, date of last production 5-22 19 62  
Was permission obtained from the Conservation Division or its agents before plugging was commenced? yes

NORTH

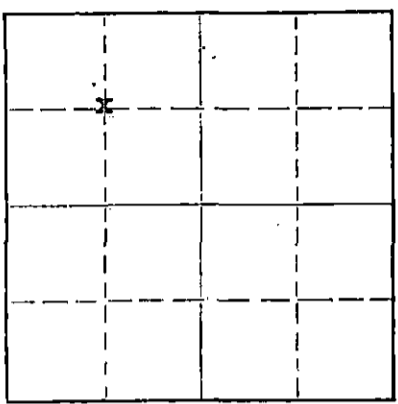

Locate well correctly on above Section Plat

Name of Conservation Agent who supervised plugging of this well Hugh Scott  
Producing formation Chester Depth to top Bottom Total Depth of Well 6112 Feet  
Show depth and thickness of all water, oil and gas formations.

OIL, GAS OR WATER RECORDS

CASING RECORD

FORMATION	CONTENT	FROM	TOPS	SIZE	PUT IN	PULLED OUT
Council Grove			2996	8-5/8"	751'	None
Pennsylvanian			3392	4-1/2"	6055'	<del>XXXX</del> 1402'
Des Moines			4978			
Morrow			5514			
Chester			5662			
St. Louis			5908			

Describe in detail the manner in which the well was plugged, indicating where the mud fluid was placed and the method or methods used in introducing it into the hole. If cement or other plugs were used, state the character of same and depth placed, from feet to feet for each plug set.

Loaded hole with 60 bbl. of water, set plug @ 5300' and dumped 4 sacks of cement with dump bailer. Pulled 4 1/2" casing. Mudded hole to 710', set rock bridge to 700' and ran 35 sacks of cement. Mudded to 55' set rock bridge to 45' and ran 15 sacks of cement to base of cellar.

PLUGGING COMPLETE.

RECEIVED  
STATE CORPORATION COMMISSION  
OCT 17 1962  
CONSERVATION DIVISION

(If additional description is necessary, use BACK of this sheet)  
Name of Plugging Contractor KNIGHT CASING PULLING COMPANY  
Address CHASE, KANSAS

STATE OF KANSAS COUNTY OF RICE, ss.  
Noel J. Knight (employee of owner) or (owner or operator) of the above-described well, being first duly sworn on oath, says: That I have knowledge of the facts, statements, and matters herein contained and the log of the above-described well as filed and that the same are true and correct. So help me God.

(Signature) Noel J. Knight  
Chase, Kansas (Address)

SUBSCRIBED AND SWORN TO before me this 2nd day of October, 1962

My commission expires May 20, 1964 Notary Public.



15-175-10062-0000

PAN AMERICAN PETROLEUM CORPORATION

WELL RECORD

SUPPLEMENTAL (ENTER "X" WHEN APPLICABLE)

Grid for well location mapping

LOCATE WELL CORRECTLY

LEASE Sam G. Specht WELL NO. 1
LOCATION OF WELL: 1320 FT. NORTH SOUTH OF THE 1320 FT.
EAST WEST OF THE WEST LINE OF THE NW 1/4 1/4 1/4
OF SECTION 10 TOWNSHIP 32 NORTH SOUTH RANGE 33 EAST WEST
Seward COUNTY Kansas STATE
ELEVATION: DE 2385 KB 2389 GL 2378
COMPLETED AS: OIL WELL GAS WELL WATER WELL DRY HOLE
DRILLING COMMENCED 2-28 62 COMPLETED 6-13 62

OPERATING COMPANY Pan American Petroleum Corporation ADDRESS Box 507 - Ulysses, Kansas

OIL OR GAS SANDS OR ZONES

Table with columns: NAME, FROM, TO, NAME, FROM, TO. Rows include Council Grove, Pennsylvania, Des Moines, Morrow, Chester, St. Louis.

WATER SANDS

Table with columns: NAME, FROM, TO, WATER LEVEL, NAME, FROM, TO, WATER LEVEL. Rows 1, 2, 3, 4.

CASING RECORD (OVERALL MEASUREMENT)

LINER SCREEN RECORD

Tables for casing and liner screen records with columns for size, weight, description, quantity, size, quantity, set at, make and type.

PACKER RECORD

Table for packer record with columns for size, length, set at, make and type.

CEMENTING RECORD

MUDDING RECORD

Tables for cementing and mudding records with columns for size, where set, cement, method, final press, method, results.

WHAT METHOD WAS USED TO PROTECT SANDS WHEN OUTER STRINGS WERE PULLED?

WERE BOTTOM HOLE PLUGS USED?

IF SO, STATE KIND, DEPTH SET, AND RESULTS OBTAINED

PBD 5300

ROTARY TOOLS WERE USED FROM 0 FEET TO 6112 FEET AND FROM FEET TO FEET

CABLE TOOLS WERE USED FROM 0 FEET TO FEET AND FROM FEET TO FEET

24-HOUR PRODUCTION OR POTENTIAL TEST Dry Hole

WATER BBLs.

IF GAS WELL, CUBIC FEET PER 24 HOURS SHUT-IN PRESSURE LBS. PER SQUARE IN.

I, THE UNDERSIGNED, BEING FIRST DULY SWORN UPON OATH, STATE THAT THIS WELL RECORD IS CORRECT ACCORDING TO THE RECORDS OF THIS OFFICE AND TO THE BEST OF MY KNOWLEDGE AND BELIEF.

Original Signed by D. M. LILES Area Superintendent

SUBSCRIBED AND SWORN TO BEFORE ME THIS 15 DAY OF June 1962

MY COMMISSION EXPIRES 11-12-62 J. G. Cherry NOTARY PUBLIC

FORMATION RECORD

DESCRIBE EACH FORMATION DRILLED. INDICATE THICKNESS, CONTENT AND WHETHER DRY, OR OIL, GAS, OR WATER BEARING.

FORMATION	TOP	BOTTOM	FORMATION	TOP	BOTTOM
Sand-Clay-sand bed	0	847			
Red bed - ssp	847	1525			
Red bed - Argay.	1525	1900			
Lime - Shale	1900	2110			
Red bed - ssp	2110	2106			
Lime - shale	2106	3003			
Lime	3003	3195			
Lime - Shale	3195	3323			
Lime	3323	3419			
Lime - Shale	3419	3523			
Lime	3523	4022			
Lime - Shale	4022	4332			
Lime	4332	4324			
Lime - Shale	4324	4510			
Lime	4510	4533			
Chart - lime	4533	4714			
Lime	4714	4720			
Lime - Shale	4720	5043			
Lime	5043	5165			
Lime - Shale	5165	5220			
Lime	5220	6112			
Total depth	6112				
Plug back depth	5900				