


WELL PLUGGING RECORD

Give All Information Completely
 Make Required Affidavit

COUNTY Seward SEC. 11 TWP. 32 RGE. 33
 Location as in quarters or footage from lines:
Nw/4 Nw/4

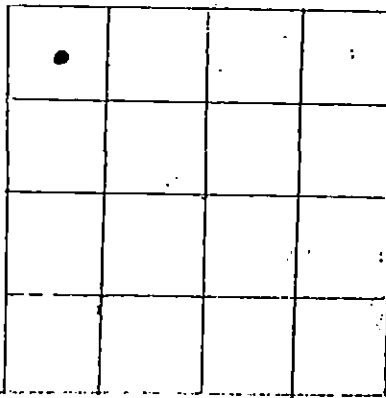

Locate Well
 correctly on above
 Section Platt.

Lease Owner First National Oil, Inc. #1347 6230
 Lease Name Printz Well No. #1-11
 Office Address 23 East 11th Liberal, KS 67901
 Character of Well (Completed as Oil, Gas or Dry Hole): Dry Hole
 Date Well Completed 10/14/82
 Application for plugging filed 10/14/82
 Plugging commenced 10/14/82
 Plugging completed 10/15/82 @ 2:00pm.
 Reason for abandonment of well or producing formation
DRY

Was permission obtained from the Conservation Division or it's
 Agent's before plugging was commenced? YES

Name of Conservation Agent who supervised plugging of this well Luthi
 Producing formation NONE Depth to top _____ bottom _____ T.D. 6013
 Show depth and thickness of all water, oil and gas formations.

OIL, GAS OR WATER RECORDS

Casing Record

Formation	Content	From	To	Size	Put in	Pulled Out
<u>None</u>						


Describe in detail the manner in which the well was plugged, indicating where the mud
 fluid was placed and the method or methods used in introducing it into the hold. If cement
 or other plugs were used, state the character of same and depth placed, from _____ feet
 to _____ feet for each plug set.

60 sacks @ 1580
35 sacks @ 680
0-40' 10 sacks and rubber plug
10 sacks rat hole
10sacks mouse hole
5 sacks water well

(If additional description is necessary, use BACK of this sheet)
 Name of Plugging Contractor Halliburton Services

STATE OF Kansas COUNTY OF Seward, ss.
Cheley A. Rodgers (employee of owner) ~~or (owner or operator)~~ of the
 above-described well, being first duly sworn on oath, says: That I have knowledge of the
 facts, statements, and matters herein contained and the log of the above-described well as
 filed and that the same are true and correct. So help me God.

(Signature) Cheley A. Rodgers
23 East 11th Liberal, KS 67901
 (Address)

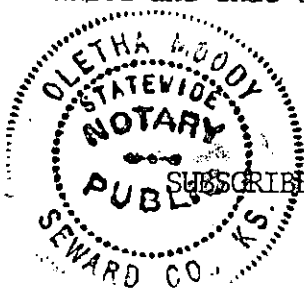

SUBSCRIBED AND SWORN TO before me this 20 day of October, 19 82

Cletha Moody
 Notary Public.
 STATE CORPORATION COMMISSION

My Commission expires: April 27, 1985

OCT 25 1982
 CONSERVATION DIVISION
 Wichita, Kansas

DRILLER'S LOG

First National Oil, Inc.
10610 Snyder Drive
La Mesa, Ca. 92041

Printz #1-11
C NW/4 of NW/4 of Sec.11-32-33
Seward County, Kansas

Surface Casing: Drilled 1527' of 12 1/2" hole.
Ran 38 jnts. of new 24# 8 5/8", total 1530.84
Set @ 1527 KB. Cemented w/600 sks. lite,
2% CC, tailed 150' class H, 3% CC.
Plug down @ 1:30am 10-1-82. Halliburton
Services.

Commenced: 9/30/82
Completed: 10/15/82

Total Depth: 6013'

FORMATION	FROM	TO	REMARKS
Surface Sand	0'	1527'	LTD: 6003'
Lime & Shale	1527'	6013'	

RECEIVED
STATE CORPORATION COMMISSION
OCT 19 1982
CONSERVATION DIVISION
Wichita, Kansas

I certify that this is a true and correct copy of the log on the above captioned well to the best of my knowledge.

NRG Drilling, Inc.
By Elmer Jack Taylor
Elmer Jack Taylor Vice-President

Subscribed and sworn to before me this 18 day of October 19 82

Marnell Pribble
Marnell Pribble

My commission expires: 8-20-83