


15-175-00542-0000

STATE OF KANSAS
STATE CORPORATION COMMISSION

Give All Information Completely
Make Required Affidavit
Mail or Deliver Report to:
Conservation Division
State Corporation Commission
211 No. Broadway
Wichita, Kansas

WELL PLUGGING RECORD

NORTH

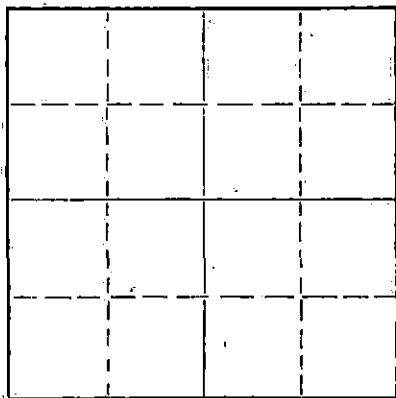

Locate well correctly on above
Section Plat

Seward County, Sec. 12 Twp. 32S Rge. 34W (E) (W)

Location as "NE/CNW*SW*" or footage from lines 50' E of C SW

Lease Owner Panhandle Eastern Pipe Line Company

Lease Name Morgan "C" Well No. 1-12

Office Address Box 351 Liberal, Kansas

Character of Well (completed as Oil, Gas or Dry Hole) Dry Hole

Date well completed 6 - 29 19 59

Application for plugging filed 6 - 29 19 59

Application for plugging approved 6 - 29 19 59

Plugging commenced 6 - 30 19 59

Plugging completed 7 - 1 19 59

Reason for abandonment of well or producing formation Dry

If a producing well is abandoned, date of last production 19

Was permission obtained from the Conservation Division or its agents before plugging was commenced? Yes

Name of Conservation Agent who supervised plugging of this well Merle A. Rives

Producing formation Depth to top Bottom Total Depth of Well 2783 Feet

Show depth and thickness of all water, oil and gas formations.

OIL, GAS OR WATER RECORDS.

CASING RECORD

FORMATION	CONTENT	FROM	TO	SIZE	PUT IN	PULLED OUT
				7	650'	None
				4 1/2	2782'	2022

Describe in detail the manner in which the well was plugged, indicating where the mud fluid was placed and the method or methods used in introducing it into the hole. If cement or other plugs were used, state the character of same and depth placed, from feet to feet for each plug set.

Spotted 3 sacks cement at 2706 top 2671. Cut off pipe at 2009 feet and pulled 2022 feet. Filled with mud to 600 feet, spotted 10 sacks cement with top at 550 feet. Filled hole with mud to 35 feet and cemented w/7 sacks cement to surface.

RECEIVED
STATE CORPORATION COMMISSION

MAY 7 1959

CONSERVATION DIVISION
Wichita, Kansas

(If additional description is necessary, use BACK of this sheet)

Name of Plugging Contractor Andrews Well Servicing Co., Inc.

Address Box 384 Liberal, Kansas

STATE OF Kansas, COUNTY OF Seward, ss.

L. W. Phillips (employee of owner) or (owner or operator) of the above-described

well, being first duly sworn on oath, says: That I have knowledge of the facts, statements, and matters herein contained and the log of the above-described well as filed and that the same are true and correct. So help me God.

(Signature) L. W. Phillips

Box 351 Liberal, Kansas

(Address)

SUBSCRIBED AND SWORN TO before me this 1 day of July, 1959

My Commission expires May 5, 1963

My commission expires

Carolyn S. Small
Notary Public.

PLUGGING
FILE SEC 12-32 R 33W
BOOK PAGE 49 LINE 20

DRILLER'S LOG

WELL NAME: Morgan C 1-12; COMPANY OPERATING: Panhandle Eastern Pipe Line Co
 ADDRESS of COMPANY: Box 351, Liberal, Kansas

WELL LOCATION: 50' E of 1/4 C 1/4 SW 1/4,
1320 ft. North of South line,
1362 ft. East of West line; Sec. 12, Twp. 32, Rge. 33, Seward County, Kansas

DRILLING STARTED 6-6, 1959; DRILLING COMPLETED 6-11, 1959
 WELL COMPLETED 6-29, 1959; WELL CONNECTED _____, 19____

ELEVATION: 2859.61 ft. Ground Level; CHARACTER OF WELL (Oil, Gas, or Dry Hole) Dry Hole

OIL OR GAS SANDS OR ZONES - PERFORATIONS - ACIDIZING AND FRACTURING INFORMATION					
Name	From	To	No. of Shots	Gallons Used	Kind Used
Krider	2749	52	12	200	15%
Krider	2742	46	16	200	15%
Krider	2724	29	20	2000	7-1/2%
Krider	2710	15	20	300	15%
Herington	2686	2700	56	3000	7-1/2%
				2000	7-1/2%
				2000	15%

CASING RECORD

Size	Amount Set	Sacks of Cement	Amount Pulled
7	650'	400	None
4 1/2	2782'	150	2022

FORMATION RECORD

Formation	Top	Bottom	Formation	Top	Bottom
Sand & Surface Clay	0	520			
Red bed	520	655			
Red bed, Shale & Shells	655	1435			
Red bed & Gype	1435	1860			
Red bed & Shale	1860	2075			
Sandy Shale & Lime	2075	2278			
Lime & Shale	2278	2437			
Lime	2437	2540			
Lime & Shale	2540	2626			
Lime	2626	2752			
Lime & Dolomite	2752	2783			

STATE CORPORATION COMMISSION
 JUL 7 1959
 CONSERVATION DIVISION
 Wichita, Kansas

RESULTS of INITIAL PRODUCTION TEST:

PLUGGING
 FILE SEC. 12132A331
 BOOK PAGE 42 LINE 20