


STATE OF KANSAS
STATE CORPORATION COMMISSION

WELL PLUGGING RECORD

Give All Information Completely
Make Required Affidavit
Mail or Deliver Report to
Conservation Division
State Corporation Comm.
245 North Water
Wichita, KS 67202

Seward County. Sec. 14 Twp. 32S Rge. 33 E/W
Location as "NE/CNW $\frac{1}{4}$ SW $\frac{1}{4}$ " or footage from lines
660' FSL & 1980' FEL
Lease Owner Yucca Petroleum Co.
Lease Name Kansas University Endowment Well No. 1-14
Office Address P. O. Box 2585 Amarillo, Texas 79105
Character of Well (Completed as Oil, Gas or Dry Hole) Dry Hole

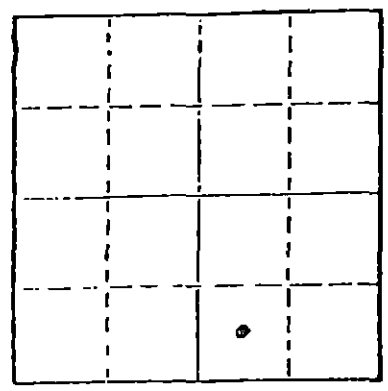

Date Well completed May 3, 1978
Application for plugging filed (verbal approval) May 3, 1978
Application for plugging approved May 8, 1978
Plugging commenced May 3, 1978
Plugging completed May 4, 1978
Reason for abandonment of well or producing formation Dry Hole

If a producing well is abandoned, date of last production 19
Dry Hole

Was permission obtained from the Conservation Division or its agents before plugging was commenced? yes

Name of Conservation Agent who supervised plugging of this well Mr. Clarence Thomas
Producing formation _____ Depth to top _____ Bottom _____ Total Depth of Well 5100'
Show depth and thickness of all water, oil and gas formations.

OIL, GAS OR WATER RECORDS

CASING RECORD

FORMATION	CONTENT	FROM	TO	SIZE	PUT IN	PULLED OUT
				8-5/8"	1620'	0

Describe in detail the manner in which the well was plugged, indicating where the mud fluid was placed and the method or methods used in introducing it into the hold. If cement or other plugs were used, state the character of same and depth placed, from _____ feet to _____ feet for each plug set.

Hole filled with drilling mud. Rigging up Halliburton and set plugs as follows using 50-50 Pozmix cement.

- Plug #1 50 sks plug from 1600' to 1776'.
- Plug #2 10 sks plug from 40' to surface.
- Plug #3 5 sks plug in rathole.

RECEIVED
STATE CORPORATION COMMISSION
MAY 12 1978

(If additional description is necessary, use BACK of this sheet)

Name of Plugging Contractor Dry hole - Plugged by Drilling Contractor, Rains & Williamson Oil Co., Inc., Wichita, Kansas.

STATE OF Kansas Texas COUNTY OF Seward Potter, ss.
I, T. P. Northern (employee of owner) or (owner or operator)

of the above-described well, being first duly sworn on oath, says: That I have knowledge of the facts, statements, and matters herein contained and the log of the above-described well as filed and that the same are true and correct. So help me God.

(Signature) T. P. Northern
P. O. Box 2585, Amarillo, Texas 79105
(Address)

SUBSCRIBED AND SWORN TO before me this 10th day of May, 1978

Patti Leach
Notary Public.



PATTI LEACH
Notary Public, in and for Potter County, Texas
My Commission Expires November 20, 1982

My commission expires _____