


15-175-00041-0000

STATE OF KANSAS
STATE CORPORATION COMMISSION

Give All Information Completely
Make Required Affidavit
Mail or Deliver Report to:
Conservation Division
State Corporation Commission
212 North Market, Insurance Bldg.
Wichita, Kansas

WELL PLUGGING RECORD

NORTH

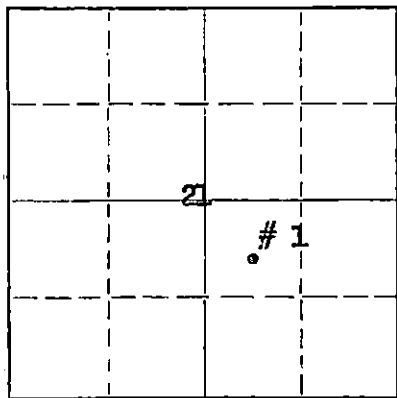

Locate well correctly on above Section Plat

Seward County, Sec. 21 Twp. 32S Rge. 33W (E) W (W)

Location as "NE/CNW/SW" or footage from lines 660' from North & West lines SE/L
Lease Owner Sinclair Oil & Gas Company
Lease Name Lemert Unit Well No. 1
Office Address P. O. Box 521, Tulsa, Oklahoma
Character of Well (completed as Oil, Gas or Dry Hole) Dry Hole
Date well completed 5-18-60 19__
Application for plugging filed 7-1-60 19__
Application for plugging approved 19__
Plugging commenced 7-11-60 19__
Plugging completed 7-14-60 19__
Reason for abandonment of well or producing formation Dry Hole

If a producing well is abandoned, date of last production 19__
Was permission obtained from the Conservation Division or its agents before plugging was commenced? Yes

Name of Conservation Agent who supervised plugging of this well Bill Lackamp
Producing formation None Depth to top Bottom Total Depth of Well Feet
Show depth and thickness of all water, oil and gas formations.

OIL, GAS OR WATER RECORDS

CASING RECORD

FORMATION	CONTENT	FROM	TO	SIZE	PUT IN	PULLED OUT
<u>No Producing formations encountered</u>						

RECEIVED
STATE CORPORATION COMMISSION
JUL 20 1960
CONSERVATION DIVISION
Wichita, Kansas

Describe in detail the manner in which the well was plugged, indicating where the material was placed and the method or methods used in introducing it into the hole. If cement or other plugs were used, state the character of same and depth placed, from feet to feet for each plug set.

Well Plugged as follows; Orig. TD 7264' - Plugged back to 2935' - Sanded hole from 2935 to 2900' with from 2900 to 2865' with 5 sacks cement, from 2865' to 310' with heavy drilling mud, from 310 to 300' with rock bridge, from 300' to 275' with 25 sacks cement. From 275' to 20' with heavy drilling mud, from 20' to base of cellar with 10 sacks cement - Hole plugged as per Mr. Bill Lackamp, State Inspector's instructions.

(If additional description is necessary, use BACK of this sheet)
Name of Plugging Contractor Knight Casing Pulling Company
Address Chase, Kansas

STATE OF Kansas COUNTY OF Rice, ss.
Virgil Johnson (employee of owner) or (owner or operator) of the above-described well, being first duly sworn on oath, says: That I have knowledge of the facts, statements, and matters herein contained and the log of the above-described well as filed and that the same are true and correct. So help me God.
(Signature) Virgil Johnson
P. O. Box 466, Chase, Kansas
(Address)

SUBSCRIBED AND SWORN TO before me this 19th day of July, 1960
L. B. Reynolds
Notary Public.
My commission expires August 13, 1962

LEMERT UNIT NO. 1

SE/4 of Section 21-32S-33W
Seward County, Kansas
Sinclair Oil & Gas Company

20" O. D. casing cemented at 125'
13-3/8" O. D. casing cemented at 627'
8-5/8" O. D. casing cemented at 2680'
5-1/2" O. D. casing cemented at 6015'

Drilling commenced 4-4-60
Drilling completed 5-23-60

FROM	TO	FORMATION	REMARKS
0'	60'	Surface	
60	490	Sand	20" O. D. casing cemented with 375 sacks at 125'
490	640	Red bed	
640	1652	Red bed & sand	13-3/8" O. D. casing cemented with 475 sacks at 627'
1652	2617	Anhydrite	
2617	2671	Dolomite & shale	
2671	2680	Anhydrite	8-5/8" O. D. casing cemented with 250 sacks at 2680'
2680	2800	Red bed & shale	
2800	2888	Sand & lime	
2888	2987	Lime & shale	
2987	3040	Shale & sand	
3040	3098	Lime & shale	
3098	3220	Shale & shells	
3220	3269	Sand & shale	
3269	3437	Lime, shale & streaks of chalk	
3437	3590	Chalky lime	
3590	3726	Lime	
3726	3737	Shale	
3737	3853	Shale & lime	
3853	3953	Lime & shale	
3953	4000	Lime	
4000	4070	Shale	
4070	4255	Shale & lime	
4255	4401	Lime & shale	
4401	4445	Shale & lime	
4445	4582	Lime & shale	
4582	4676	Lime	
4676	4783	Lime & shale	
4783	5091	Lime	
5091	5508	Lime & shale	
5508	5544	Lime & sand	
5544	5579	Sand & lime	
5579	5656	Shale & lime	
5656	5751	Lime & shale	
5751	5781	Shale & sand	

RECEIVED
STATE CORPORATION COMMISSION

JUL 20 1960

CONSERVATION DIVISION
Wichita, Kansas

FROM	TO	FORMATION	REMARKS
5781'	5823'	Shale & lime	
5823	6238	Lime	
6238	6285	Lime & chert	
6285	6502	Lime	
6502	6555	Lime & chert	
6555	6590	Chert	
6590	6647	Lime & chert	
6647	6667	Chert	
6667	6698	Lime & chert	
6698	6719	Chert & lime	
6719	6778	Lime & chert	
6778	6780	Chert & lime	
6780	6829	Lime & chert	
6829	6862	Chert & lime	
6862	6911	Lime & chert	
6911	6957	Chert & lime	
6957	7062	Lime & chert	
7062	7069	Lime & chert, Arbuckle	
7069	7095	Lime & shale	
7095	7264	Lime	Plugged back and 5-1/2" O. D. casing cemented with 500 sacks at 6015'
T. D. 7264'			

This is a true copy of the driller's log as shown on the drilling tickets.

BARBOUR DRILLING COMPANY

By: *E. W. Pribil*

Subscribed and sworn to before me on this 3rd day of June, 1960.

Merry Jane Burt
Notary Public

My commission expires July 27, 1961.