


STATE OF KANSAS
STATE CORPORATION COMMISSION

WELL PLUGGING RECORD

Give All Information Completely
Make Required Affidavit
Mail or Deliver Report to
Conservation Division
State Corporation Comm.
245 North Water
Wichita, KS 67202

Morton County, Sec. 9 Twp. 32S Rge. 41 E/W
Location as "NE/CNW/SW" or footage from lines

C-SE
Lease Owner Cimarron Petroleum Corporation
Lease Name Dreyer Well No. CPC#114
Office Address Ste. 116, 2233 W. Lindsey, Norman, OK
Character of Well (Completed as Oil, Gas or Dry Hole) D&A

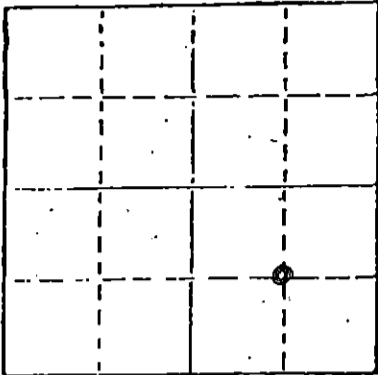

Locate well correctly on above Section Plat

Date Well completed 19
Application for plugging filed 1-9- 1979
Application for plugging approved 19
Plugging commenced 1-10- 1979
Plugging completed 1-10- 1979
Reason for abandonment of well or producing formation

DRY
If a producing well is abandoned, date of last production 19

Was permission obtained from the Conservation Division or its agents before plugging was commenced?

Name of Conservation Agent who supervised plugging of this well
Producing formation Depth to top Bottom Total Depth of Well 5375'
Show depth and thickness of all water, oil and gas formations.

OIL, GAS OR WATER RECORDS

CASING RECORD

FORMATION	CONTENT	FROM	TO	SIZE	PUT IN	PULLED OUT
		0	1496'	8 5/8"		0

Describe in detail the manner in which the well was plugged, indicating where the mud fluid was placed and the method or methods used in introducing it into the hold. If cement or other plugs were used, state the character of same and depth placed, from feet to feet for each plug set. Plugged

- 30 sks Class H Cement Plug @ 5375' back to 5285'
- 20 sks Class H Cement Plug @ 4900' back to 4840'
- 20 sks Class H Cement Plug @ 3500' back to 3440'
- 20 sks Class H Cement Plug @ 3200' back to 3140'
- 60 sks Class H Cement Plug @ 1650' back to 1400' in Surface Pipe
- 10 sks Class H Cement Plug @ 33' back to 3'
- 5 sks Class H Cement Plug in Rat Hole
- 5 sks Class H Cement Plug in Mouse Hole

RECEIVED
STATE CORPORATION COMMISSION
FEB 15 1979
CONSERVATION DIVISION
Wichita, Kansas

(If additional description is necessary, use BACK of this sheet)

Name of Plugging Contractor DaMac Drilling Company
Box 1164, Great Bend, Kansas

STATE OF Oklahoma COUNTY OF Cleveland, ss.
Thurman Heck (employee of owner) or (owner or operator)

of the above-described well, being first duly sworn on oath, says: That I have knowledge of the facts, statements, and matters herein contained and the log of the above-described well as filed and that the same are true and correct. So help me God.

(Signature) Thurman Heck
2233 W. Lindsey, Suite 116
Norman, OK (Address) 73069

SUBSCRIBED AND SWORN TO before me this 22 day of February, 19

Kimberly Kay Barnett
Notary Public.

My commission expires 8-16-82

WELL LOG

COMPANY Cimarron Petroleum

SEC. 9 T. 32S R. 41W

FARM CPC Dryer NO. #114

LOC. C SE Section


TOTAL DEPTH 5375'

COUNTY Morton County, Kansas

COMM. 12-27-78 COMP. 1-10-79

CONTRACTOR DaMac Drilling Inc.

CASING 8 5/8 set @ 1496'

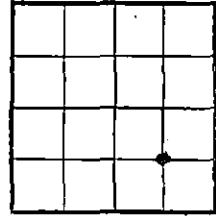

ELEVATION

PRODUCTION

P and A

FIGURES INDICATE BOTTOM OF FORMATIONS

Surface	0	130
RedBed, Sand	130	1100
Sand	1100	1184
RedBed	1184	1500
Anhydrite, Shale	1500	2307
Shale, Lime	2307	5164
Shale	5164	5177
Shale, Lime	5177	5215
Morrow	5215	5220
Lime, Shale	5220	5375 RTD

RECEIVED
STATE CORPORATION COMMISSION
FEB 15 1979
CONSERVATION DIVISION
Wichita, Kansas

State of Kansas
County of Barton } SS

I, RoAnn H. Anderson of DaMac Drilling Inc.

upon oath state the above and foregoing is a true and correct copy of the log of the CPC #114 Dryer well.

Subscribed and sworn to before me this 25th day of January 1979

My Commission Expires: 4-28-81 Lana L. Remmert

NOTARY PUBLIC
LANA L. REMMERT,
Barton County, Kansas
My Appt. Exp. 4-28-81