

15-129-10001-0000

STATE OF KANSAS  
STATE CORPORATION COMMISSION  
CONSERVATION DIVISION  
P. O. BOX 17027  
WICHITA, KANSAS 67217

FORM CP-4

WELL PLUGGING RECORD

Morton County, Sec 10 Twp 32S Rge 41W (E) (W)

Location as "NE/CNW&SW&SE" or footage from lines SW NE  
Lease Owner Powell & Stone

Lease Name Dean Well No. 1

Office Address 217 Town & Country Village, Palo Alto, California 94301

Character of Well (completed as Oil, Gas or Dry Hole)

Date well completed May 30, 1961

Application for plugging filed Nov. 30 1975

Application for plugging approved Dec. 1 1975


Plugging commenced Dec. 1 1975

Plugging completed Dec. 3 1975

Reason for abandonment of well or producing formation Water Production

If a producing well is abandoned, date of last production March 1975

Was permission obtained from the Conservation Division or its agents before plugging was commenced? Yes

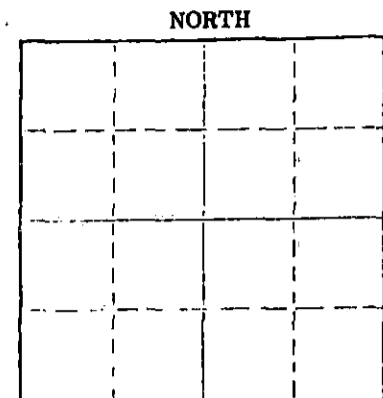

Locate well correctly on above Section Plat

Name of Conservation Agent who supervised plugging of this well Clarence Thomas

Producing formation Lower Morrow & Keyes Depth to top 5176 Bottom 5278 Total Depth of Well 5364

Show depth and thickness of all water, oil and gas formations.

OIL, GAS OR WATER RECORDS

CASING RECORD

FORMATION	CONTENT	FROM	TO	SIZE	PUT IN	PULLED OUT
				8 5/8	1194	none
				5 1/2	5364	3025

Describe in detail the manner in which the well was plugged, indicating where the mud fluid was placed and the method or methods used in introducing it into the hole. If cement or other plugs were used, state the character of same and depth placed, from feet to feet for each plug set.

Pumped 20 sks. of cement with top of plug @ 5000 ft.  
Pumped 10 sks. of cement @ 1000 to 900 ft.  
Put 15 sks. of cement @ 15 to 0

RECEIVED  
STATE CORPORATION COMMISSION  
JAN 13 1976  
CONSERVATION DIVISION  
Wichita, Kansas

(If additional description is necessary, use BACK of this sheet)

Name of Plugging Contractor Sargents Casing Pulling Service Kansas No. 511

Address Box 506 Liberal, Kansas 67901

STATE OF Oklahoma COUNTY OF Woodward

William R Braley (employee of owner) or (owner or operator) of the above-described well, being first duly sworn on oath, says: That I have knowledge of the facts, statements, and matters herein contained and the log of the above-described well as filed and that the same are true and correct. So help me God.

(Signature) William R Braley  
PO Box 447 Gage OK 73843  
(Address)

SUBSCRIBED AND SWORN to before me this 2 day of January, 1976

My commission expires July 27 1977  
Notary Public.

15-129-10001-0000

WELL LOG BUREAU—KANSAS GEOLOGICAL SOCIETY  
508 East Murdock, Wichita, Kansas


COPY

Company ALAMO CORP.  
Farm Dean, No. 1

SEC. 10 T. 32 R. 41W  
C NW SE

Total Depth. 5536'  
Comm. 12-10-60 Comp. 12-31-60  
Shot or Treated.  
Contractor. R. W. Rine Drig. Co.  
Issued, 7-1-61

County Morton  
KANSAS

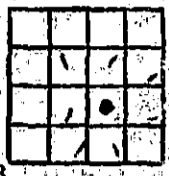

CASINO:  
8 5/8" 1494' cem w/675 sx.  
5 1/2" 5362' cem w/200 sx.

Elevation. 2405' RB

Production. 14,200,000 CFG

Figures indicate Bottom of Formations.

surface & red bed	750
red bed & gyp	1282
red bed, gyp & Anhy.	1341
red bed & gyp	1496
shale & lime	2172
shale, lime & sand	2390
lime & shale	4467
lime	4699
lime & shale	4775
lime w/shale strks	4830
lime & shale	5034
shale	5208
sand & shale	5303
lime	5320
lime & shale	5448
chert & lime	5498
lime	5536
Total Depth	

RECEIVED  
STATE CORPORATION COMMISSION

DEC. 1 1975

CONSERVATION DIVISION  
Wichita, Kansas

TOPS: SCOUT	
Anhydrite	1482
Krider	2142
Winfield	2193
Wabaunsee	2858
Topeka	3125
Toronto	3568
Missourian	3608
Des Moines	4256
Morrow Sand	5103
Chester	5294
St. Genevieve	5356
St. Louis	5414