

STATE OF KANSAS
STATE CORPORATION COMMISSION


WELL PLUGGING RECORD

Give All Information Completely
Make Required Affidavit
Mail or Deliver Report to:
Conservation Division
State Corporation Commission
211 No. Broadway
Wichita, Kansas

Morton County, Sec. 13 Twp. 32S Rge. 41W (E) (W)

Location as "NE/CNW/SW" or footage from lines Center SW/4
Lease Owner Stanolind Oil and Gas Company
Lease Name Daniel Gas Unit Well No. 1
Office Address Box 591, Tulsa, Oklahoma
Character of Well (completed as Oil, Gas or Dry Hole) Dry Hole
Date well completed as a Dry Hole 11-7-1955
Application for plugging filed 11-10-1955
Application for plugging approved 11-14-1955
Plugging commenced 11-21-1955
Plugging completed 11-21-1955
Reason for abandonment of well or producing formation No commercial production encountered
If a producing well is abandoned, date of last production Not produced 19
Was permission obtained from the Conservation Division or its agents before plugging was commenced? Yes

NORTH

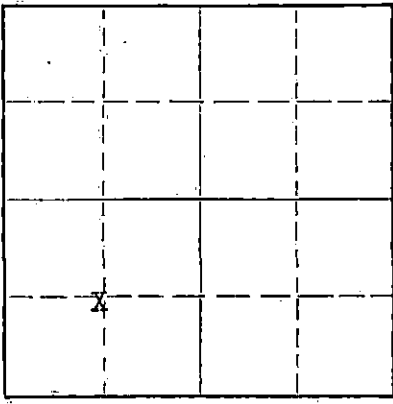

Locate well correctly on above Section Plat

Name of Conservation Agent who supervised plugging of this well Mr. M. A. Rives, Pratt, Kansas
Producing formation Permian Depth to top -- Bottom -- Total Depth of Well 2295 Feet
Show depth and thickness of all water, oil and gas formations. PBD 2265

OIL, GAS OR WATER RECORDS

CASING RECORD

FORMATION	CONTENT	FROM	TOP	SIZE	PUT IN	PULLED OUT *
Herington-Krider	No Comm. Prod.		2223	8-5/8"	432'	None
Winfield	" " "		2285	5 1/2"	2295'	None
						*Casing cut off 5' below Surface

Describe in detail the manner in which the well was plugged, indicating where the mud fluid was placed and the method or methods used in introducing it into the hole. If cement or other plugs were used, state the character of same and depth placed, from feet to feet for each plug set.
Halliburton Oil Well Cementing Company pumped 125 cu. ft. of Pozmix #1 cement into the 5 1/2" casing, followed by 35 sacks of Magcogel mud. Maximum and standing pressure 1000 psi. Casing cut off 5' below ground level and original contours restored.

RECEIVED
STATE CORPORATION COMMISSION
JAN 14 1956
CONSERVATION DIVISION
Wichita, Kansas

Name of Plugging Contractor Halliburton Oil Well Cementing Co.
Address P. O. Drawer 1431, Duncan, Oklahoma

STATE OF Kansas COUNTY OF Grant, ss.
W. M. Warren (employee of owner) or (owner or operator) of the above-described well, being first duly sworn on oath, says: That I have knowledge of the facts, statements, and matters herein contained and the log of the above-described well as filed and that the same are true and correct. So help me God.

(Signature) W M Warren Field Supt.
Box 507, Ulysses, Kansas (Address)

SUBSCRIBED AND SWORN TO before me this 11 day of January, 1956

My commission expires November 12, 1958

J. G. Cherry Notary Public.

PLUGGING
FILE SEC 13 T 32 R 41W
BOOK PAGE 15 LINE 33