


STATE OF KANSAS
STATE CORPORATION COMMISSION

Give All Information Completely
Make Required Affidavit
Mail or Deliver Report to:
Conservation Division
State Corporation Commission
800 Bittling Building
Wichita, Kansas

WELL PLUGGING RECORD

Morton County, Sec. 19 Twp. 32 Rge. 40 (X) (W)

Location as "NE/CNW/SW" or footage from lines Gen NW/1
Lease Owner J. M. Huber Corporation
Lease Name Heiken Well No. 1
Office Address Box 978 - Liberal, Kansas
Character of Well (completed as Oil, Gas or Dry Hole) Dry Hole
Date well completed 3-6-54 19
Application for plugging filed 3-6-54 19
Application for plugging approved 3-6-54 19
Plugging commenced 4-5-54 19
Plugging completed 4-5-54 19
Reason for abandonment of well or producing formation Dry Hole

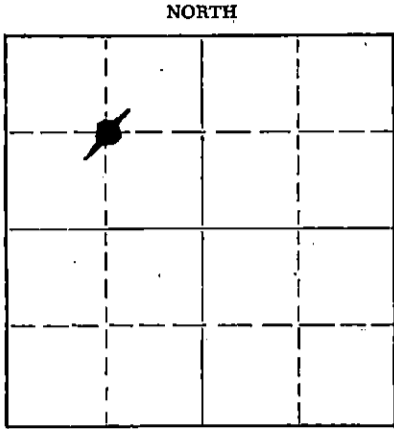

Locate well correctly on above Section Plat

If a producing well is abandoned, date of last production _____ 19
Was permission obtained from the Conservation Division or its agents before plugging was commenced? Yes

Name of Conservation Agent who supervised plugging of this well Mr. M. A. Rives
Producing formation _____ Depth to top _____ Bottom _____ Total Depth of Well 5650 Feet
Show depth and thickness of all water, oil and gas formations. PB Total Depth 2425'

OIL, GAS OR WATER RECORDS

CASING RECORD

FORMATION	CONTENT	FROM	TO	SIZE	PUT IN	PULLED OUT
				13-3/8"	480'	None
				9-5/8"	2400'	761'

Describe in detail the manner in which the well was plugged, indicating where the mud fluid was placed and the method or methods used in introducing it into the hole. If cement or other plugs were used, state the character of same and depth placed, from _____ feet to _____ feet for each plug set.

Filled hole with mud laden fluid from 5650 to 2609'; set cement bridge of 75 sacks of cement at 2609'; bridge with rock from 2450 to 2441. Filled with cement from 2441 to 2425'; tested Hugoton gas pay; Dry Hole. Filled with Cal Seal from 2425' to 2378'. Set cement bridge of 30 sacks of cement from 2312' to 2234'. Shot and recovered 761' of 9-5/8" casing. Filled with mud laden fluid from 2234' to 400'. Set bridging plug at 400'; filled with 10' of rock and 20 sacks of cement to 365'. Filled with mud laden fluid to 20'. Set bridging plug at 20'. Filled with 5' of rock and 15 sacks of cement to top of hole.

RECEIVED
STATE CORPORATION COMMISSION
APR 20 1954
CONSERVATION DIVISION
Wichita, Kansas

(If additional description is necessary, use BACK of this sheet)
Name of Plugging Contractor J. M. Huber Corporation
Address Box 978 - Liberal, Kansas

STATE OF KANSAS COUNTY OF SEWARD SS.
T. R. E. McDaniel (employee of owner) or (owner) of the above-described well, being first duly sworn on oath, says: That I have knowledge of the facts, statements, and matters herein contained and the log of the above-described well as filed and that the same are true and correct. So help me God.

(Signature) T. R. E. McDaniel
Box 978 - Liberal, Kansas
(Address)

SUBSCRIBED AND SWORN TO before me this 19th day of April, 19 54

My commission expires July 27, 1957 L. R. L. Notary Public.

PLUGGING
FILE SEC 19 T32 R40W
PAGE 25 LINE 35

