

STATE OF KANSAS  
STATE CORPORATION COMMISSION


Give All Information Completely  
Make Required Affidavit  
Mail or Deliver Report to:  
Conservation Division  
State Corporation Commission  
211 No. Broadway  
Wichita, Kansas

WELL PLUGGING RECORD

Morton County, Sec. 21 Twp. 32 Rge. 40 (E) W (W)

Location as "NE/CNW/SW" or footage from lines C SW NE  
Lease Owner Pan American Petroleum Corporation  
Lease Name W. C. Light ~~XXX~~ Gas Unit "B" Well No. 1  
Office Address Ulysses, Kansas  
Character of Well (completed as Oil, Gas or Dry Hole) Dry Hole  
Date well completed 6-14 19 61  
Application for plugging filed 7-2 19 62  
Application for plugging approved 7-2 19 62  
Plugging commenced 6-28-62 19  
Plugging completed 6-28-62 19  
Reason for abandonment of well or producing formation Depleted. No commercial quantities of oil or gas present.  
If a producing well is abandoned, date of last production None 19  
Was permission obtained from the Conservation Division or its agents before plugging was commenced? yes

NORTH

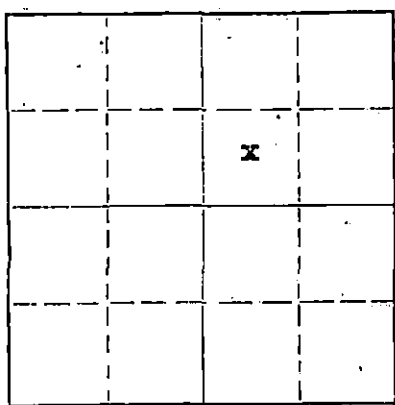

Locate well correctly on above Section Flat

Name of Conservation Agent who supervised plugging of this well Scott  
Producing formation None Depth to top \_\_\_\_\_ Bottom \_\_\_\_\_ Total Depth of Well 5650 Feet  
Show depth and thickness of all water, oil and gas formations.

OIL, GAS OR WATER RECORDS

CASING RECORD

FORMATION	CONTENT	FROM	TO ps	SIZE	PUT IN	PULLED OUT
Council Grove			2530	10-3/4"	702'	None
Pennsylvania			2950	4-1/2"	3408'	864'
Morrow			5020			

Describe in detail the manner in which the well was plugged, indicating where the mud fluid was placed and the method or methods used in introducing it into the hole. If cement or other plugs were used, state the character of same and depth placed, from \_\_\_\_\_ feet to \_\_\_\_\_ feet for each plug set.

Checked hole to 2681', sanded to 2500' and dumped 3 sacks of cement @ 2500' with dump bailer. Pulled 4 1/2" casing to 700' and pumped in 30 sacks of cement. Pulled balance of 4 1/2" casing, checked fluid @ 218', mudded to 30', set rock bridge to 20' and ran 10 sacks of cement to base of cellar.

PLUGGING COMPLETE.

RECEIVED  
STATE CORPORATION COMMISSION  
JUL 26 1962  
CONSERVATION DIVISION  
Wichita, Kansas

(If additional description is necessary, use BACK of this sheet)  
Name of Plugging Contractor KNIGHT CASING PULLING COMPANY  
Address CHASE, KANSAS

STATE OF KANSAS COUNTY OF RICE, ss.  
Noel J. Knight (employee of owner) or owner or operator of the above-described well, being first duly sworn on oath, says: That I have knowledge of the facts, statements, and matters herein contained and the log of the above-described well as filed and that the same are true and correct. So help me God.

(Signature) Noel J. Knight  
Chase, Kansas  
(Address)

SUBSCRIBED AND SWORN TO before me this 3rd day of July, 19 62

My commission expires May 20, 1964

Milton J. Volin  
Notary Public.



FORMATION RECORD

DESCRIBE EACH FORMATION DRILLED. INDICATE THICKNESS, CONTENT AND WHETHER DRY, OR OIL, GAS, OR WATER BEARING.

FORMATION	TOP	BOTTOM	FORMATION	TOP	BOTTOM
Sand	0	475	Lime	4660	4828
Sand, Redbed	475	705	Lime, Shale	4828	4974
Redbed	705	1107	Shale	4974	5372
Sand	1107	1453	Shale, Lime	5372	5480
Gyp, Shale	1453	1578	Lime	5480	5509
Anhy, Shale	1578	2624	Shale, Lime	5509	5611
Shale, Lime	2624	2742	Lime	5611	5650
Lime	2742	2780			
Shale, Lime	2780,	4660			
			TD 5650'		
			PID 2681'		