


STATE OF KANSAS
STATE CORPORATION COMMISSION

Give All Information Completely
Make Required Affidavit
Mail or Deliver Report to:
Conservation Division
State Corporation Commission
211 No. Broadway
Wichita, Kansas

WELL PLUGGING RECORD

Sumner County, Sec. 27 Twp. 33S Rge. (E) 1 (W)

Location as "NE/CNW/SW" or footage from lines SE/4 NE/4 SW/4
Lease Owner Walters Drilling Co., et al
Lease Name Felt Well No. 1
Office Address 510 Orpheum Building, Wichita 2, Kansas
Character of Well (completed as Oil, Gas or Dry Hole) Dry Hole
Date well completed April 24, 19 59
Application for plugging filed (verbal) April 24, 19 59
Application for plugging approved (verbal) April 24, 19 59
Plugging commenced April 24, 19 59
Plugging completed April 24, 19 59
Reason for abandonment of well or producing formation Dry Hole

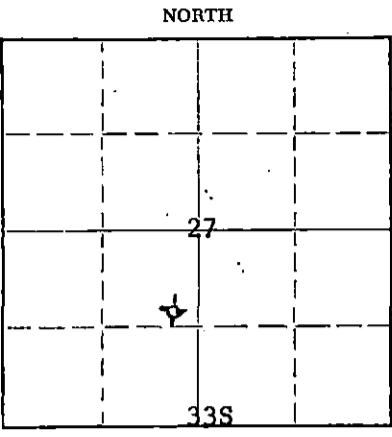

Locate well correctly on above Section Plat

If a producing well is abandoned, date of last production 19
Was permission obtained from the Conservation Division or its agents before plugging was commenced? Yes

Name of Conservation Agent who supervised plugging of this well Eugene Graham, Winfield, Kansas
Producing formation None Depth to top Bottom Total Depth of Well 4376 Feet
Show depth and thickness of all water, oil and gas formations.

OIL, GAS OR WATER RECORDS

CASING RECORD

FORMATION	CONTENT	FROM	TO	SIZE	PUT IN	PULLED OUT
None	None	0	240'	8 5/8"	240'	None
	No oil string - D & A					

Describe in detail the manner in which the well was plugged, indicating where the mud fluid was placed and the method or methods used in introducing it into the hole. If cement or other plugs were used, state the character of same and depth placed, from feet to feet for each plug set.

Filled hole with heavy mud to 220'; set bottom plug at 220' with 15 sacks cement

Filled hole with heavy mud to 30', set top plug at 30' with 8 sacks cement

RECEIVED
STATE CORPORATION COMMISSION
APR 29 1959
CONSERVATION DIVISION
Wichita, Kansas

(If additional description is necessary, use BACK of this sheet)
Name of Plugging Contractor Walters Drilling Co.
Address 510 Orpheum Building, Wichita 2, Kansas

STATE OF Kansas, COUNTY OF Sedgwick, ss.
Robert F. Walters (Employee of owner or owner or operator) of the above-described well, being first duly sworn on oath, says: That I have knowledge of the facts, statements, and matters herein contained and the log of the above-described well as filed and that the same are true and correct. So help me God.
(Signature) Robert F. Walters
510 Orpheum Building, Wichita 2, Kansas (Address)

SUBSCRIBED AND SWORN TO before me this 28th day of April, 19 59

My commission expires March 10, 1960 Notary Public.

PLUGGING
FILE SEC. 27 T. 33S R. 1W
BOOK PAGE 24 LINE 18

FELT NO. 1

Location: SE/4 NE/4 SW/4 Sec. 27-33S-1W, Date Spudded: 4-7-59
 Sumner County, Kansas
 Completion: 4-24-59
 Operator: Walters Drilling Co. Elevation: 1208 Gr
 Contractor: Walters Drilling Co. 1211 DF
 1214 KB
 Surface Casing: 8 5/8" set at 240' with 135
 sacks cement and 2 Cal.
 Chloride
 Oil String: None. D & A

L O G

(Figures indicate bottom of formation)

Surface	0 to 240
Shale and Shells	520
Shale and Lime	3145
Lime, Shale and Sand	3283
Lime and Shale	3950
Lime	3959
Lime and Shale	3997
Lime, Shale and Chert	4015
Lime, Shale, Chert Streaks	4036
Lime	4057
Lime and Chert	4075
Lime	4113
Lime and Shale	4174
Lime	4220
Lime, Shale and Chert	4257
Lime and Shale	4333
Shale	4345
Sand	4365
Shale and Sand	4376
Total Depth	4376

RECEIVED
 STATE CORPORATION COMMISSION

APR 29 1959

CONSERVATION DIVISION
 WICHITA, KANSAS

The undersigned, Robert F. Walters, hereby certifies that the above log is a true and correct log of the formations encountered in drilling the above noted well as reflected by the Daily Drilling Reports.

WALTERS DRILLING CO.

By

Robert F. Walters

Subscribed and sworn to before me
 this 28th day of April, 1959

Pauline Henderson
 Notary Public

My commission expires:
 March 10, 1960

