

STATE CORPORATION COMMISSION OF KANSAS
OIL & GAS CONSERVATION DIVISION
WELL COMPLETION OR RECOMPLETION FORM
ACO-1 WELL HISTORY
DESCRIPTION OF WELL HISTORY

Operator: License # 5208
Name MOBIL OIL CORPORATION
Address P.O. BOX 5444

City/State/Zip DENVER, COLORADO 80217

Purchaser _____

Operator Contact Person B. R. MAYNARD
Phone (303) 298-2069

Contractor: License # 5141
Name ZENITH DRILLING CORP.

Wellsite Geologist M. PRICE
Phone (303) 298-3669

Designate Type of Completion
 New Re-Entry Workover

Oil SWD Temp Abd
 Gas Inj Delayed Comp.
 Dry Other (Core, Water Supply, etc.)

If OWHI: old well info as follows;
Operator _____
Well Name _____
Comp. Date _____

WELL HISTORY

Drilling Method:
 Mud Rotary Air Rotary Cable

3-26-88 4-8-88 4-8-88
Spud Date Date Reached TD Completion Date
TA'D

6800' 3130'
Total Depth PBTD

Amount of Surface Pipe Set and Cemented at 1765 feet
Multiple Stage Cementing Collar Used? Yes No
If yes, show depth set _____ feet
If alternate 2 completion, cement circulated
from _____ feet depth to _____ w/ SX cat
Cement Company Name _____
Invoice # _____

API No. 15- 189-21172-00-00

COUNTY STEVENS

SW SW SW Sec 14 Twp 34S Rge 38 East
 West

650 Ft North from Southeast Corner of Section
4671.2 Ft West from Southeast Corner of Section
(Note: Locate well in section plat below)


Lease Name BEAVERS #1 UNIT WELL # 3

Field Name WILDCAT

Producing Formation LOWER MORROW, ST. LOUIS

Elevation: Ground 3205' KB 3221'

SECTION PLAT

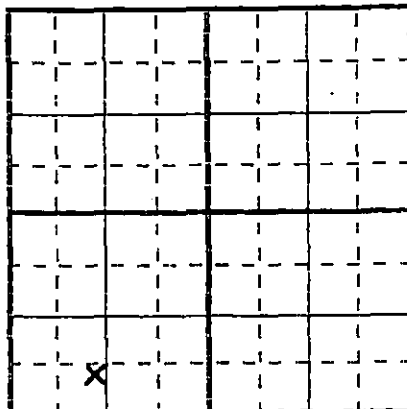

WATER SUPPLY INFORMATION

Disposition of Produced Water: _____ Disposal
Docket # NA _____ Repressuring

Questions on this portion of ACO-1 call:

Water Resources Board (913) 296-3717

Source of Water:
Division of Water Resources Permit# T88-154

Groundwater 815 Ft. North from Southeast Corner
(well) 4671 Ft. West from Southeast Corner of
Sec 14 Twp 34S Rge 38 East West

Surface Water _____ Ft. North from Southeast Corner
(Stream, pond etc) _____ Ft. West from Southeast Corner
Sec _____ Twp _____ Rge _____ East _____ West

Other (explain) _____
(purchased from city, R.W.D. #)

INSTRUCTIONS: This form shall be completed in triplicate and filed with the Kansas Corporation Commission, 200 Colorado Derby Building, Wichita, Kansas 67202, within 120 days of the spud date of any well. Rule 82-3-130, 82-3-107, and 82-3-106 apply. Information on side two of this form will be held confidential for a period of 12 months if requested in writing and submitted with the form. See rule 82-3-107 for confidentiality in excess of 12 months. One copy of all wireline logs and drillers time log shall be attached with this form. Submit cp-4 form with all plugged wells. Submit cp-111 from with all temporarily abandoned wells.

All requirements of statutes, rules and regulations promulgated to regulate the oil and gas industry have been fully complied with and the statements herein are complete and correct to the best of my knowledge.

Signature B. R. Maynard B. R. MAYNARD Q08

Title REGULATORY COMPLIANCE MANAGER Date 7-1-88

Subscribed and sworn to before me this 1st day of July
1988
Notary Public George George
Date Commission Expires 1/3/91

K.C.C. OFFICE USE ONLY
 Letter of Confidentiality Attached
 Wireline Log Received
 Drillers Timelog Received
Distribution _____
 KCC _____ SWD/Rep _____ NGPA
 KGS _____ Plug/III _____ Other
5-100 (Specify)
UNIVERSITY OF KANSAS
7-5-88 Wichita, Kansas