


STATE OF KANSAS
STATE CORPORATION COMMISSION

Give All Information Completely
Make Required Affidavit
Mail or Deliver Report to:
Conservation Division
State Corporation Commission
800 Bitting Building
Wichita, Kansas

WELL PLUGGING RECORD

NORTH

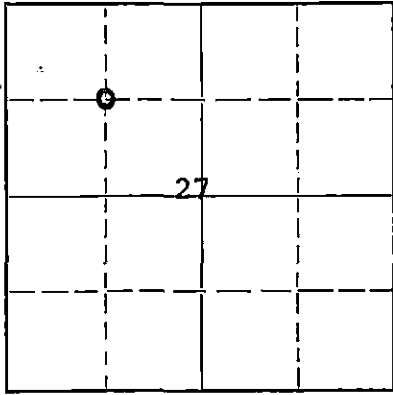

Locate well correctly on above
Section Plat

Meade County. Sec. 27 Twp. 33S Rge. (E) 29 (W)
Location as "NE/CNW/SW" or footage from lines Center NW/4
Lease Owner Sun Oil Company
Lease Name Oyler Well No. 1
Office Address Box 1348, Tulsa, Oklahoma
Character of Well (completed as Oil, Gas or Dry Hole) Dryhole
Date well completed 11-6- 19 59
Application for plugging filed by phone 11-6- 19 59
Application for plugging approved 11-6- 19 59
Plugging commenced 11-6- 19 59
Plugging completed 11-6- 19 59
Reason for abandonment of well or producing formation Dryhole

If a producing well is abandoned, date of last production Dryhole 19
Was permission obtained from the Conservation Division or its agents before plugging was commenced? Yes

Name of Conservation Agent who supervised plugging of this well Mr. Broadfoot
Producing formation None Depth to top Bottom Total Depth of Well 5925 Feet
Show depth and thickness of all water, oil and gas formations.

OIL, GAS OR WATER RECORDS

CASING RECORD

FORMATION	CONTENT	FROM	TO	SIZE	PUT IN	PULLED OUT
				8-5/8"	1493'	None
Morrow Sh & Ls						
	DST 5748-5815: Show gas & oil cut mud.					

Describe in detail the manner in which the well was plugged, indicating where the mud fluid was placed and the method or methods used in introducing it into the hole. If cement or other plugs were used, state the character of same and depth placed, from feet to feet for each plug set.

Hole filled w/mud to 1500' (in 8-5/8" csg.) 15 sax cement spotted in 8-5/8" 1500-1455'; Mud from 1455-300'; 15 sax cement 300-255'; mud from 255-30' 10 sax cement 30'-0'. Welded steel cap on 8-5/8" surface casing.

STATE CORPORATION COMMISSION
JAN 20 1960
1-20-1960
CONSERVATION DIVISION
Wichita, Kansas

(If additional description is necessary, use BACK of this sheet)
Name of Plugging Contractor Capitt Drilling, Inc.
Address Union Center Bldg., Wichita, Kansas

STATE OF OKLAHOMA, COUNTY OF TULSA, ss.
J. H. Allen (employee of owner) or (~~owner or operator~~) of the above-described well, being first duly sworn on oath, says: That I have knowledge of the facts, statements, and matters herein contained and the log of the above-described well as filed and that the same are true and correct. So help me God.

(Signature) J. H. Allen
J. H. Allen
Box 1348, Tulsa, Oklahoma
(Address)

SUBSCRIBED AND SWORN TO before me this 19th day of January, 19 60.

My commission expires July 25, 1962

Dorothy Little
Notary Public.

15-119-00095-0000

WELL LOG BUREAU, KANSAS GEOLOGICAL SOCIETY
508 East Murdock, Wichita, Kansas


Company- SUN OIL CO.
Farm- Oylor No. 1

SEC. 27 T. 33 R. 29W
C NW/4

Total Depth. 5925'
Comm. 10-13-59 Comp. 11-6-59
Shot or Treated.
Contractor. Capitt Drlg.
Issued. 1-16-60

County Meade

KANSAS

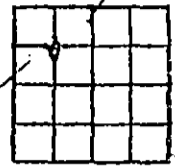

Elevation. 2551'

CASING:

8 5/8" 1056' cem w/1000 sx.

Production. Dry

Figures Indicate Bottom of Formations.

clay, sand, shale	240
red bed	665
shale & lime	1138
shale, sand, lime	1342
lime & shale	1720
shale	2015
lime w/strks, shale	2667
lime & shale	3685
shale	3807
lime w/shale strks.	3930
shale w/lime strks.	4361
lime & shale strks.	4559
Lansing lime	4559
lime w/shale strks	5031
Marmaton lime	5180
lime & shale	5206
lime	5330
lime w/strks shale	5724
Morrow shale	5730
shale & lime	5823
Mississippi lime	5925
Total Depth	

TOPS: SCOUT

Lansing	4557
Marmaton	5207
Cherokee	5414
Morrow	5723
Chester	5822