

15-119-10125-0000


Give All Information Completely
Make Required Affidavit
Mail or Deliver Report to
Conservation Division
State Corporation Commission
211 No. Broadway
Wichita, Kansas

WELL PLUGGING RECORD

Meade County, Sec. 29 Twp. 33 Rge. 29 (E) (W)

Location as "NE/CNWxSWx" or footage from lines C SW SW
Lease Owner Panhandle Eastern Pipe Line Company
Lease Name Behnke Well No. 02
Office Address Box 828, Liberal, Kansas
Character of Well (completed as Oil, Gas or Dry Hole) Dry Hole
Date well completed 10-26 1957
Application for plugging filed 7-12 1963
Application for plugging approved 7-17 1963
Plugging commenced 8-13 1963
Plugging completed 8-14 1963
Reason for abandonment of well or producing formation Dry

NORTH

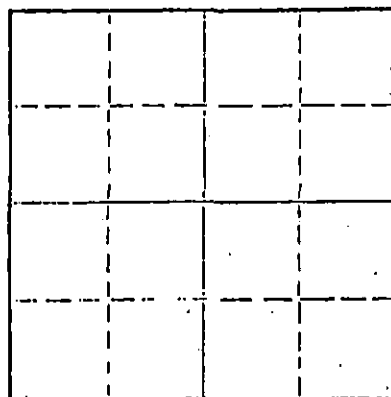

Locate well correctly on above
Section Plot

If a producing well is abandoned, date of last production ----- 19
Was permission obtained from the Conservation Division or its agents before plugging was commenced? Yes

Name of Conservation Agent who supervised plugging of this well Hugh Scott
Producing formation None Depth to top Bottom Total Depth of Well 6000 Feet

Show depth and thickness of all water, oil and gas formations:

OIL, GAS OR WATER RECORDS

CASING RECORD

FORMATION	CONTENT	FROM	TO	SIZE	PUT IN	PULLED OUT
				8 5/8	1640	
				4 1/2	5 950	3193

Describe in detail the manner in which the well was plugged, indicating where the mud fluid was placed and the method or methods used in introducing it into the hole. If cement or other plugs were used, state the character of same and depth placed, from feet to feet for each plug set.

Spotted 35 sxs cmt @ 700' and 15 sxs @ surface; welded on cap.

RECEIVED
STATE CORPORATION COMMISSION

AUG 21 1963

CONSERVATION DIVISION
Wichita, Kansas

(If additional description is necessary, use BACK of this sheet)

Name of Plugging Contractor Sargents Casing Pulling Service
Address 121 W. 9th, Liberal, Kansas

STATE OF Kansas, COUNTY OF Seward, ss.
C. G. Melton (employee of owner) or (owner or operator) of the above-described

well, being first duly sworn on oath, says: That I have knowledge of the facts, statements, and matters herein contained and the log of the above-described well as filed and that the same are true and correct. So help me God.

(Signature) C. G. Melton

Box 828, Liberal, Kas.
(Address)

SUBSCRIBED AND SWORN TO before me this 19th day of August, 1963

My Commission Expires Oct. 3, 1966

Hazel S. Nelson Hazel S. Nelson
Notary Public.

My commission expires

15-119-10125-0000

WELL LOG BUREAU—KANSAS GEOLOGICAL SOCIETY
508 East Murdock, Wichita, Kansas


COPY

Company: Panhandle Eastern Pipe Line Company,
Farm: Behnke No. 02

SEC. 29 T. 33 R. 29W.
G SW SW
660' N. fr. SL. & 660'
E. Fr. WL. SW/4

Total Depth: 6000'
Comm. 9-10-57 Comp. 10-26-57
Shot or Treated.
Contractor: Earl F. Wakefield,
Issued: 12-21-57

County Meade KANSAS

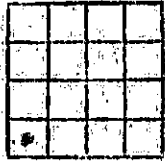

CASING:

8" @ 1640'
4" @ 5950'

Elevation: 2640.1 RB

Production: Dry

Figures indicate Bottom of Formations.

sand & clay	300
sandy red bed	683
red bed	1335
sand	1376
red bed & sand	1490
Anhydrite	1536
red bed W/strks. Anhydrite	1651
Anhydrite, Dolomite & shale red	1942
shale & lime W/strks. Anhydrite	2288
shale, shells & strks. of Anhydrite	2435
shale W/lime & chert strks	2671
shale & lime	2734
lime	2855
lime & Anhydrite	2890
shale & chalky lime	2930
shale & lime	3025
lime	3190
lime W/chalky strks.	3291
chalky lime	3515
lime W/chalky strks.	3612
chalky lime	3714
lime	3818
lime W/chalky strks.	3923
shale	4200
shale & shells	4313
shale & lime strks.	4423
shale & lime	4651
lime	4825
lime W/strks. Chert	4862
lime	5010
lime & shale	5156
lime	5263
lime & shale	5327
lime	5357
lime W/strks. shale	5423
lime & shale	5452
lime	5517
lime & shale	5751
Coring	5931
lime	5972
lime	6000
Total Depth	

Mississippian	5856
Perforations:	
5886-5893	
5849-5856	
5291-97	
5274-5278	
5265-5270	
5241-5246	

Well Treatment Record:

- A/500 gals MA-10-11-57
- A/5000 gals RA & A/15,000 gals 5%-10-12-57
- A/500 gals MA-10-17-57
- A/500 gals 15% MA-10-19-57
- A/2000 gals 15%-10-25-57

TOPS:

Krider	2740
Winfield	2817
Towanda	2877
Heebner	4436
Toronto	4489
Lansing	4611
Marmaton	5237
Cherokee	5410
Atoka	5578
Morrow	5751
Lower Morrow Sand Zone	5845