

15-119-10139-0000

STATE OF KANSAS
STATE CORPORATION COMMISSION

Give All Information Completely
Make Required Affidavit
Mail or Deliver Report to:
Conservation Division
State Corporation Commission
800 Biting Building
Wichita, Kansas

WELL PLUGGING RECORD

Meade County, Sec. 31 Twp. 33S Rge. 30 (E) (W)

Location as "NE/CNW/SE/SW" or footage from lines 2310' from west, 330' from South

Lease Owner The Shamrock Oil and Gas Corp.

Lease Name Anna Ballard et al "A" Well No. 1

Office Address Box 631, Amarillo, Texas

Character of Well (completed as Oil, Gas or Dry Hole) Dry Hole

Date well completed December 27, 19 56

Application for plugging filed December 27, 19 56

Application for plugging approved December 27, 19 56


Plugging commenced December 27, 19 56

Plugging completed December 27, 19 56

Reason for abandonment of well or producing formation Dry and abandoned

If a producing well is abandoned, date of last production 19

Was permission obtained from the Conservation Division or its agents before plugging was commenced? Yes

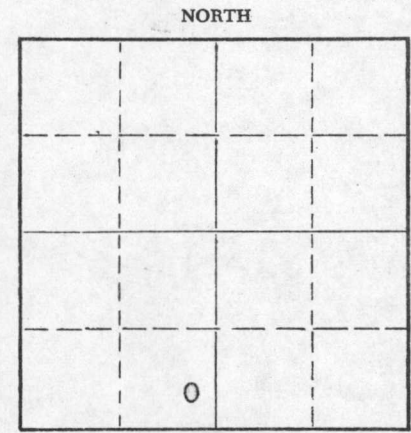

Locate well correctly on above Section Plat

Name of Conservation Agent who supervised plugging of this well Merle Rives

Producing formation None Depth to top - Bottom - Total Depth of Well 5981 Feet

Show depth and thickness of all water, oil and gas formations.

OIL, GAS OR WATER RECORDS

CASING RECORD

FORMATION	CONTENT	FROM	TO	SIZE	PUT IN	PULLED OUT
Surface sand, and red beds	Water	900	960	13 3/8"	960	-0-

Describe in detail the manner in which the well was plugged, indicating where the mud fluid was placed and the method or methods used in introducing it into the hole. If cement or other plugs were used, state the character of same and depth placed, from feet to feet for each plug set.

Went in hole open ended and spotted 75 sacks from 5,979' to 5,782'. Pushed 13 3/8" OD Halliburton plug to 550'. Spotted 35 sacks of cement from 550' to 506'. Pushed 13 3/8" OD Halliburton plug to 20' below ground level and filled hole from 20' to surface with 15 sacks cement.

RECEIVED
STATE CORPORATION COMMISSION

JAN 2 1957
1-2-57

Name of Plugging Contractor Halliburton Oil Well Cementing Company
Address Great Bend, Kansas

STATE OF TEXAS, COUNTY OF POTTER, ss.
T. S. Clopton (employee of owner) or (owner or operator) of the above-described

well, being first duly sworn on oath, says: That I have knowledge of the facts, statements, and matters herein contained and the log of the above-described well as filed and that the same are true and correct. So help me God.

(Signature) T. S. Clopton
Box 631, Amarillo, Texas (Address)

SUBSCRIBED AND SWORN TO before me this 28th day of December, 19 56

PAULINE POWELL
Notary Public

Pauline Powell
Potter County, Texas
Notary Public.

My commission expires 6-1-57

PLUGGING
FILE SEC 31 T. 33 R. 30W
BOOK PAGE 129 LINE 28

ANNA BALLARD ET AL "A" NO. 1
Section 31, Township 33 South,
Range 30 West, Meade County,
Kansas

0	960	Surface sand and red bed
960	2,365	Shale and shells
2,365	2,760	Anhydrite and dolomite
2,760	2,985	Dolomite
2,985	3,925	Lime
3,925	4,535	Lime and shale
4,535	4,885	Lime
4,885	5,813	Lime and shale
5,813	5,907	Shale, lime, and sand
5,907	5,979	Lime and shale

RECEIVED

STATE CORPORATION COMMISSION

PLUGGING

FILE SEC 31 T 33 R 20 W JAN 2 1937

BOOK PAGE 129 LINE 28 CONSERVATION DIVISION
Wichita, Kansas