
15-119-10011-0000

STATE OF KANSAS
STATE CORPORATION COMMISSION

Give All Information Completely
Make Required Affidavit
Mail or Deliver Report to:
Conservation Division
State Corporation Commission
800 Bitting Building
Wichita, Kansas

WELL PLUGGING RECORD

NORTH

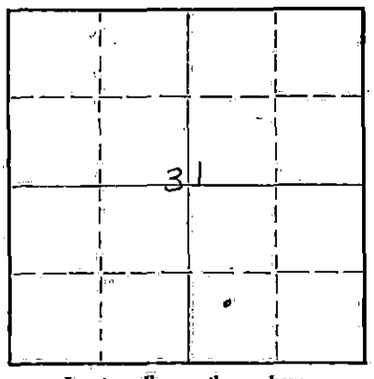

Locate well correctly on above Section Plat

Meade County. Sec. 31 Twp. 33 Rge. 29 (E) (W)

Location as "NE/CNW¼SW¼" or footage from lines 200' N of C SW SE

Lease Owner Colorado Oil and Gas Corporation

Lease Name Adams Well No. 1-31

Office Address P. O. Box 999, Liberal, Kansas

Character of Well (completed as Oil, Gas or Dry Hole) Dry Hole

Date well completed 2-11-60 19

Application for plugging filed 2-10-60 19

Application for plugging approved 2-11-60 19

Plugging commenced 5:00 PM 2-11-60 19

Plugging completed 7 PM 2-11-60 19

Reason for abandonment of well or producing formation No producing formations

If a producing well is abandoned, date of last production - 19

Was permission obtained from the Conservation Division or its agents before plugging was commenced? Yes

Name of Conservation Agent who supervised plugging of this well W. L. Lackamp

Producing formation None Depth to top ____ Bottom ____ Total Depth of Well 6017KB Feet

Show depth and thickness of all water, oil and gas formations.

OIL, GAS OR WATER RECORDS — CASING RECORD

FORMATION	CONTENT	FROM	TO	SIZE	PUT IN	PULLED OUT
Permian	Water	239	517	8 5/8"	1564'	None

Describe in detail the manner in which the well was plugged, indicating where the mud fluid was placed and the method or methods used in introducing it into the hole. If cement or other plugs were used, state the character of same and depth placed, from ____ feet to ____ feet for each plug set.

Filled hole with havy mud. Pushed wooden plug to 600'. Cemented on top of plug to 480'. Filled hole with mud. Set wooden plug at 30', filled hole with cement to bottom of cellar approximately 3 1/2' below ground level.

RECEIVED
STATE CORPORATION COMMISSION
2-23-1960
FEB 25 1960
CONSERVATION DIVISION
Wichita, Kansas

(If additional description is necessary, use BACK of this sheet)

Name of Plugging Contractor Holm Drilling Company

Address Tulsa, Oklahoma

STATE OF Kansas, COUNTY OF Seward, ss.

A. J. Smith (employee of owner) or (owner or operator) of the above-described well, being first duly sworn on oath, says: That I have knowledge of the facts, statements, and matters herein contained and the log of the above-described well as filed and that the same are true and correct. So help me God.

(Signature) A. J. Smith

P. O. Box 999, Liberal, Kansas
(Address)

SUBSCRIBED AND SWORN TO before me this 12th day of February, 19 60

William B. Claunch
Notary Public.

My commission expires 11-1-60

15-119-10011-0000

WELL RECORD

COLORADO OIL & GAS CORPORATION

ADAMS 1-31

Location: 200' N of C SW SE Section 31-T33S-R29W
Field: Singley
County: Meade
Elevation: 2669 G.L. 2676 D.F. 2679 K.B.
Commenced: January 13, 1960 Completed: February 11, 1960
Contractor: Holm Drilling Compnay

Casing Record: 8-5/8" 24# J-55 S.S. Set @ 1564' w/900 sacks Pozmix.

Drilling Log:

0- 120	Sand & Clay	3000-3800	Lime
120- 475	Sand, Clay & Shale	3800-4330	Shale w/stks Lime
475- 930	Shale & Shells	4330-4380	Lime
930-1415	Shale, Shells & Sd.	4380-4510	Shale w/strks Lime
1415-1515	Shale & Shells	4510-4630	Lime
1515-1565	Shale & Anhy.	4630-4660	Shale
1565-1610	Anhydrite	4660-5816	Lime w/Shale strks.
1610-1875	Sandy Shale	5816-5910	Shale
1875-2376	Shale & Shells	5910-6017	Lime & Shale
2376-2660	Lime & Shale	6017	RTD
2660-2725	Shale & Lime		
2725-3007	Lime & Shale		

Geological Information:

Council Grove:	3165 (-486)	Cherokee:	5476 (-2797)
Heebner:	4481 (-1802)	Atoka:	5652 (-2973)
Lansing:	4650 (-1971)	Morrow:	5816 (-3137)
Marmaton:	5311 (-2632)	Miss:	5945 (-3266)

PLUGGED & ABANDONED 2-11-60

RECEIVED
STATE CORPORATION COMMISSION
MAR 18 1970
CONSERVATION DIVISION
Wichita, Kansas