

15-119-00136-0000

STATE OF KANSAS
STATE CORPORATION COMMISSION

Form CP-4


WELL PLUGGING RECORD

Give All Information Completely
Make Required Affidavit
Mail or Deliver Report to:
Conservation Division
State Corporation Commission
211 No. Broadway
Wichita, Kansas

Meade County. Sec. 31 Twp. 33S Rge. (E) 29 (W)

Location as "NE/CNW/SW" or footage from lines NW/4 SE/4 SW/4
Lease Owner Graham-Michaelis Corporation
Lease Name Ballard Well No. 1
Office Address 211 North Broadway, Wichita, Kansas 67202
Character of Well (completed as Oil, Gas or Dry Hole) Gas
Date well completed December 7, 19 59
Application for plugging filed December 27, 19 71
Application for plugging approved (verbal) December 27, 19 71
Plugging commenced December 28, 19 71
Plugging completed December 28, 19 71
Reason for abandonment of well or producing formation Non commercial

NORTH

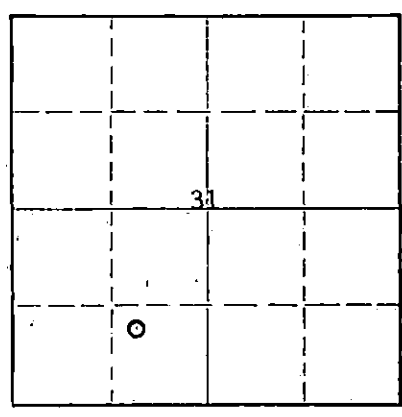

Locate well correctly on above
Section Plat

If a producing well is abandoned, date of last production May, 19 71
Was permission obtained from the Conservation Division or its agents before plugging was commenced? Yes (verbal)

Name of Conservation Agent who supervised plugging of this well Edgar J. Eves, Sublette, Kansas
Producing formation Morrow Sand Depth to top 5805 Bottom 5881 Total Depth of Well 6000 Feet
Show depth and thickness of all water, oil and gas formations.

OIL, GAS OR WATER RECORDS

CASING RECORD

FORMATION	CONTENT	FROM	TO	SIZE	PUT IN	PULLED OUT
				8 5/8"	1477'	none
				5 1/2"	5926'	2820'

Describe in detail the manner in which the well was plugged, indicating where the mud fluid was placed and the method or methods used in introducing it into the hole. If cement or other plugs were used, state the character of same and depth placed, from _____ feet to _____ feet for each plug set.

Mixed 25 sacks cement and 1 sack hulls to plug perfs at 5,841'.
Stop plug at 5,606'.
Pumped 35 sacks cement at 900' to 800'.
Put 15 sacks cement at 45' to 0'.

RECEIVED
STATE CORPORATION COMMISSION
JAN 26 1972
CONSERVATION DIVISION
Wichita, Kansas

(If additional description is necessary, use BACK of this sheet)

Name of Plugging Contractor Bob Sargent Casing Pulling Service
Address 102 W. Walnut, Liberal, Kansas

STATE OF Kansas, COUNTY OF Sedgwick, ss.
John L. James (employee of owner) or (owner or operator) of the above-described well, being first duly sworn on oath, says: That I have knowledge of the facts, statements, and matters herein contained and the log of the above-described well as filed and that the same are true and correct. So help me God.

(Signature) John L. James
John L. James - Geologist
211 North Broadway, Wichita, Kansas 67202
(Address)

SUBSCRIBED AND SWORN to before me this 25th day of January, 19 72.

My commission expires _____
MURIEL F. C. JERAM
NOTARY PUBLIC
SEDGWICK COUNTY, KANSAS
MY COMMISSION EXPIRES
JULY 25, 1972

Muriel F. C. Jeram
Notary Public.